

Chickasaw Co. Recorder  
 Cindy Messersmith  
**Fee Book 2016-0348**  
 03/16/2016 @0928AM  
 SCC SEC COR CERT # Pages: 1  
 Book: Page: \$7.00  
 Total Fees:

PREPARED BY / RETURN TO: KENNETH D. STARK IOWA DEPARTMENT OF TRANSPORTATION 426 43rd ST. SW MASON CITY, IA 50401 641-423-7564

**UNITED STATES PUBLIC LAND SURVEY CORNER CERTIFICATE**

OF

Land Survey Monuments situated in Section 10<sup>3</sup>, Township 95N, Range 14W  
 of the Fifth Principal Meridian, CHICKASAW County, Iowa.

Previously recorded in NA in County Recorder's Office.  
(book, page, document number, etc.)

(Show reason for preparing this certificate, the evidence and detailed procedures used in establishing the corner positions and monumentation found or placed.)

Monument Description and Remarks: NW CORNER: Replaced previously found SMN/IDOT washer with a SMN/IDOT Sec. Cor. washer, 3.1' +/- North of US 18 per IDOT information of record supplied by New Hampton Office after HMA resurfacing project MP-018-2(707)220-76-19.


Reason for cert: Monumentation and ties have changed.

N/4 CORNER: Replaced previously found SMN/IDOT washer with a SMN/IDOT Sec. Cor. washer, 1.2' +/- South of US 18 per IDOT information of record supplied by New Hampton Office after HMA resurfacing project MP-018-2(707)220-76-19.

Reason for cert: Monumentation and ties have changed.

**PLAN - VIEW**

(Show a minimum of three reference ties to durable physical objects, relevant monuments and physical conditions that will enable recovery of the corner.)

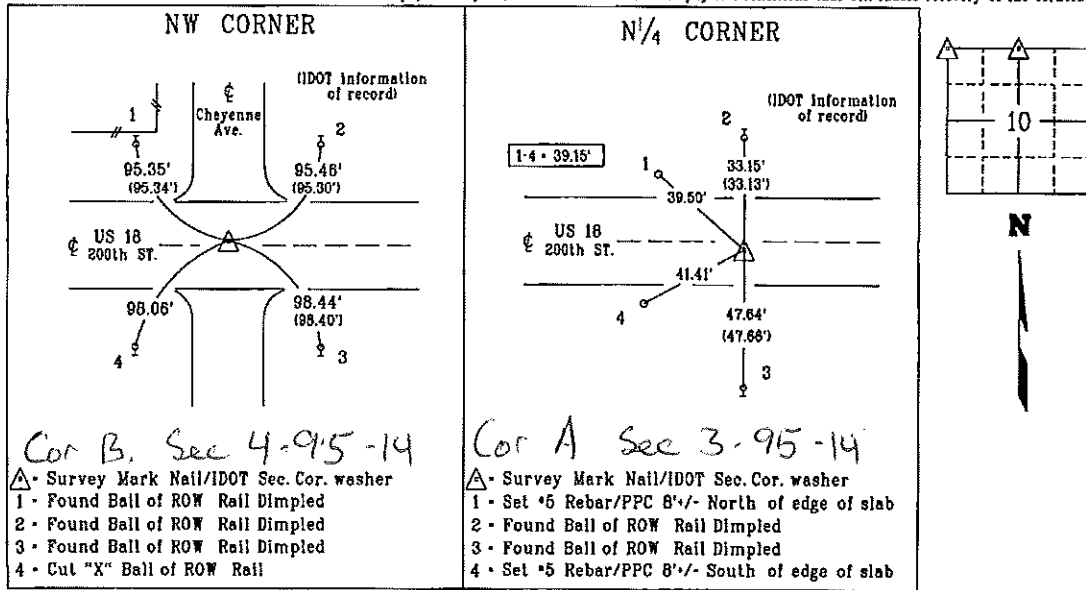

List Corners to be Indexed

Corner	Section	Township	Range
NW CORNER	10	95N	14W
N/4 CORNER	10	95N	14W

SMN - Survey Mark Nail  
 PPC - Pink Plastic Cap

drawn by: cjs 02/15



I hereby certify that this land surveying document was prepared and the related survey work was performed by me or under my personal supervision and that I am duly licensed Land Surveyor under the laws of the state of Iowa.

*Kenneth D. Stark* Date 03-14-16  
 Kenneth D. Stark  
 License number 10898  
 My License renewal date is December 31, 2017  
 Pages or sheets covered by this seal. 1

Chickasaw Co. Recorder  
 Cindy Messersmith  
**Fee Book 2014-0868**  
 07/08/2014 @11:05AM  
 SCC SEC COR CERT  
 Book: Page: # Pages: 1  
 Total Fees: \$7.00

Prepared by & Return to: Herold - Reicks Surveying, 10 East Main Street, New Hampton, IA 50659, Ph. 641-394-2725

**UNITED STATES PUBLIC LAND SURVEY CORNER CERTIFICATE**

Land Survey Monuments situated in Section 4, Township 95 North, Range 13 West of the Fifth Principal Meridian, Chickasaw County, Iowa. Not previously recorded in the County Recorder's office.

This certificate is being prepared in compliance with Iowa Code Chapter 355.11 because:

- There is no certificate on file for this corner.
- There are no longer three valid ties of record.
- There are changes to reference ties of record.
- There is change of monumentation of record.
- To clarify description of record monument (ties).


Monument Description and Remarks:

**SE Corner:** Fd. Survey Mark Nail w/I.D.O.T. Stainless Steel Washer.

Note: Corner was recovered from information obtained from the Iowa Department of Transportation, As-Built Plans Project No. FR-18-7(31)--26-19, the previous Alum. Disk was replaced after an HMA Overlay Project.

**PLAN - VIEW**

(Show a minimum of three reference ties to durable physical objects, relevant monuments and physical conditions that will enable recovery of the corner.)

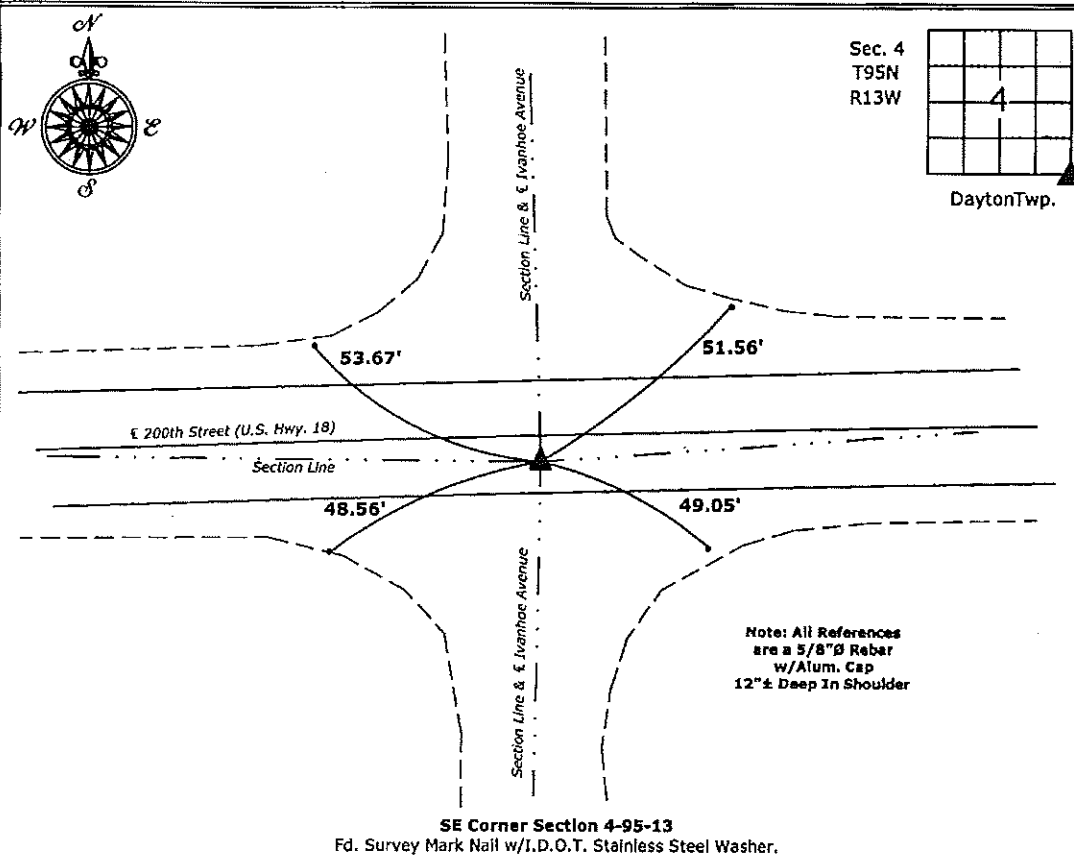

**SE Corner Section 4-95-13**  
 Fd. Survey Mark Nail w/I.D.O.T. Stainless Steel Washer.



I hereby certify that this land surveying document was prepared and the related survey work was performed by me or under my direct personal supervision and that I am a duly licensed Land Surveyor under the laws of the State of Iowa.

*Paul R. Herold* 7-8-14  
 Paul R. Herold Date:  
 License number 15525  
 My license renewal date is December 31, 2014.  
 Sheets covered by this seal: Individual sheet only

List Corners to be Indexed			
Corners	Section	Twp.	Range
SE	4	95	13
Project Number: 2014-045			
FB: Chickasaw County 6, Pgs. 31-34			

File: S:\\_CSD Projects\County Control Systems\CHICKASAW\CHICK-27.dwg, 7/8/2014 10:13:50 AM