



Prepared by: Erdman Engineering, P.C., 708 Commerce Drive ,P.O. Box 246, Decorah, Iowa, (563)382-4194

UNITED STATES PUBLIC LAND SURVEY CORNER CERTIFICATE
 OF

Land Survey Monuments situated in Section 13, Township 96 North, Range 14 West, of
 the Fifth Principal Meridian, Chickasaw County, Iowa, Previously recorded in does not apply in the
 County Recorder's Office.

Monument Description and Remarks:

This certificate is prepared in accordance with Section 355.11 of the Code of Iowa. No previous certificates have been filed for these corner locations.


Center Section: We found no record of the Center of Section 13 being set. We found no evidence of a monument in the field other than an existing fence corner with fence lines running north and east. We found the W 1/4 Corner, N 1/4 Corner, E 1/4 Corner and the S 1/4 Corner. The plat of survey recorded in Book 2003-3318 in the Chickasaw County Recorder's Office shows a computed location for the Center of Section 13 at the intersection of the lines from the opposite 1/4 corners. We set a 1/2" diameter steel bar with 1 1/2" aluminum cap #11442 at the recorded distance of 2646.01' from the W 1/4 Corner and 2659.46' from the N 1/4 Corner as the Center of Section 13, Township 96 North, Range 14 West.

PLAN-VIEW
 (NOT TO SCALE)


Center Section

Set 1/2" diameter steel
 bar with 1 1/2" aluminum
 cap #11442

Cor. O
 Sec. 13-96-14

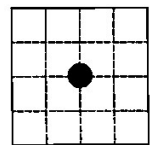


SECTION 13

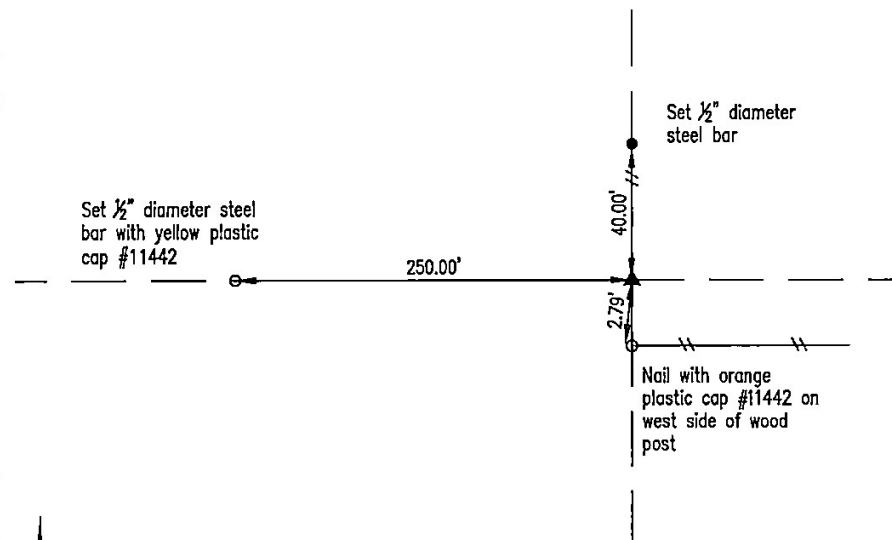

I hereby certify that this land surveying document was prepared and the related survey work was performed by me or under my direct personal supervision and that I am a duly licensed Land Surveyor under the laws of the State of Iowa.

Lindsay Erdman 2/1/24
 Date

Lindsay Erdman, P.E. & P.L.S.
 Licensed Professional Land Surveyor
 Iowa License Number 11442
 My License renewal date is December 31, 2024
 Pages or sheets covered by this seal: THIS SHEET ONLY

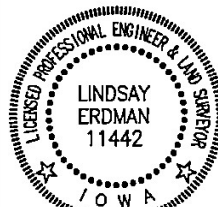

List Corner(s) to be Indexed

Corner(s)	Section	Township	Range
CS	13	96N	14W

ERDMAN
ENGINEERING, P.C.
 CIVIL ENGINEERING & LAND SURVEYING
 Decorah, Iowa