

Chickasaw Co. Recorder
 Cindy Messersmith
 Fee Book 2012-1137
 06/13/2012 @1012AM
 SCC SEC COR CERT
 Book: Page: # Pages: 1
 Total Fees: \$7.00



Prepared by: Erdman Engineering, P.C., 708 Commerce Drive, P.O. Box 246, Decorah, Iowa 52101 (563) 382-4194

United States Public Land Survey Corner Certificate
 of

Land Survey Monuments situated in Section 9, Township 96, Range 14 West of
 the 5th Principal Meridian in Chickasaw County, Iowa. Previously recorded in
does not apply in the county Recorder's Office.

Monument Description and Remarks: This certificate is prepared in accordance with Section 355.11 of the Code of Iowa. No previous certificate has been filed for this corner location. We found no record of the S $\frac{1}{4}$ Corner being set. We found no evidence of a monument in the field other than an existing fence corner with fence lines running east, west and south. We found the SW Corner and the SE Corner. We computed the location of the theoretical location of the S $\frac{1}{4}$ Corner on line and midway between the SW corner and the SE Corner. This location was $\pm 5'$ north of the fence corner and 21' west of the fence corner. We set a $\frac{1}{2}$ " diameter steel bar with 1 $\frac{1}{2}$ " aluminum cap on the north side of the wood post as the S $\frac{1}{4}$ Corner of Section 9, Township 96 North, Range 14 West.

Plan-View

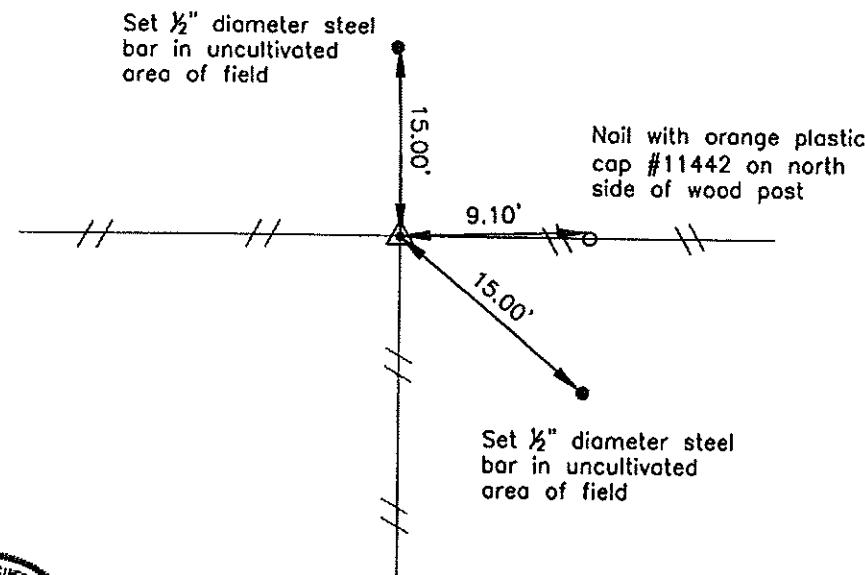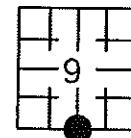

Cor. A
 9-96-14

I hereby certify that this land surveying document was prepared and the related survey work was performed by me or under my direct personal supervision and that I am a duly licensed Land Surveyor under the laws of the State of Iowa.

Signature: Lindsay Erdman
 Lindsay Erdman, P.E. and P.L.S. Iowa License Number 11442

Date: 6/11/12

My license renewal date is December 31, 2012

Corner(s) to be Indexed

Corner	Section	Township	Range
S 1/4	9	96	14