



Prepared by: Erdman Engineering, P.C., 708 Commerce Drive, P.O. Box 246, Decorah, Iowa 52101 (563) 382-4194

United States Public Land Survey Corner Certificate
 of

Land Survey Monuments situated in Section 9, Township 96, Range 14 West of the 5th Principal Meridian in Chickasaw County, Iowa. Previously recorded in does not apply in the county Recorder's Office.

Monument Description and Remarks: This certificate is prepared in accordance with Section 355.11 of the Code of Iowa. No previous certificate has been filed for this corner location. We found no record of the SSE 1/8 Corner being set. We found no evidence of a monument in the field other than an existing fence line running east and west. We found the SE Corner and set the S 1/4 Corner. We set a 1/2" diameter steel bar with 1 1/2" aluminum cap #11442 on line and midway between the SE Corner and the S 1/4 Corner as the SSE 1/8 Corner of Section 9, Township 96 North, Range 14 West.

Plan-View

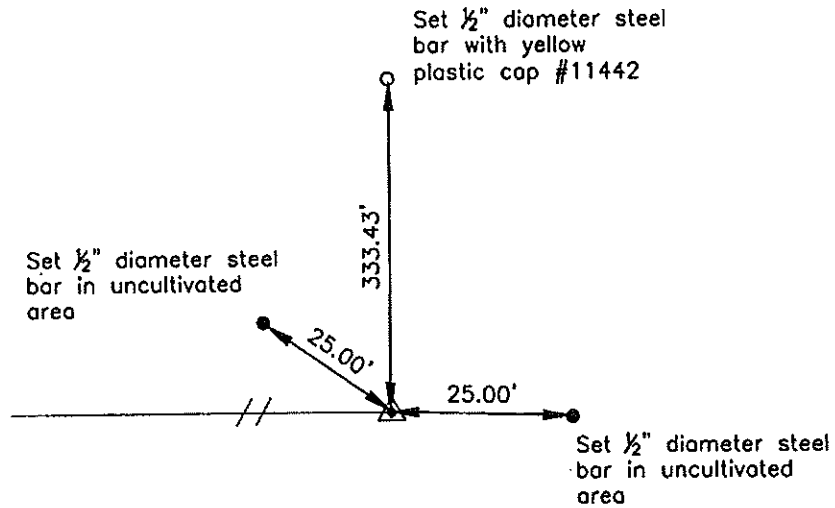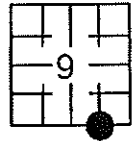

cor A1
9-96-14

I hereby certify that this land surveying document was prepared and the related survey work was performed by me or under my direct personal supervision and that I am a duly licensed Land Surveyor under the laws of the State of Iowa.

Signature *Lindsay Eroman*
 Lindsay Eroman, P.E. and P.L.S. Iowa License Number 11442

Date: 6/11/12

My license renewal date is December 31, 2012

Corner(s) to be Indexed

Corner	Section	Township	Range
SSE 1/8	9	96	14