



Prepared by & Return to: Herold - Reicks Surveying, 10 East Main Street, New Hampton, IA 50659, Ph. 641-394-2725

United States Public Land Survey Corner Certificate

Land Survey Monument situated in
 Section 17, Township 96 North, Range 14 West of the Fifth Principal Meridian, Chickasaw County, Iowa.
 Not on file in the County Recorder's office.

This certificate is being prepared in compliance with Iowa Code Chapter 355.11 because:


- There is no certificate on file for this corner.
- There are no longer three valid ties of record.
- There are changes to reference ties of record.
- There is change of monumentation of record.
- To clarify description of record monument (ties).

Monument Description and Remarks:

Northwest Corner: Set 5/8"Ø Rebar w/2"Ø Aluminum Cap PLS 19211 on the Southwest side of a lone steel fence post with information obtained from Survey and Plat, as recorded in Document #2002-0331 on file in the County Recorder's Office, position matches distances to adjacent corners in the Section within reason and matches local occupation.

Plan View

(Show a minimum of three reference ties to durable physical objects, relevant monuments and physical conditions that will enable recovery of the corner.)

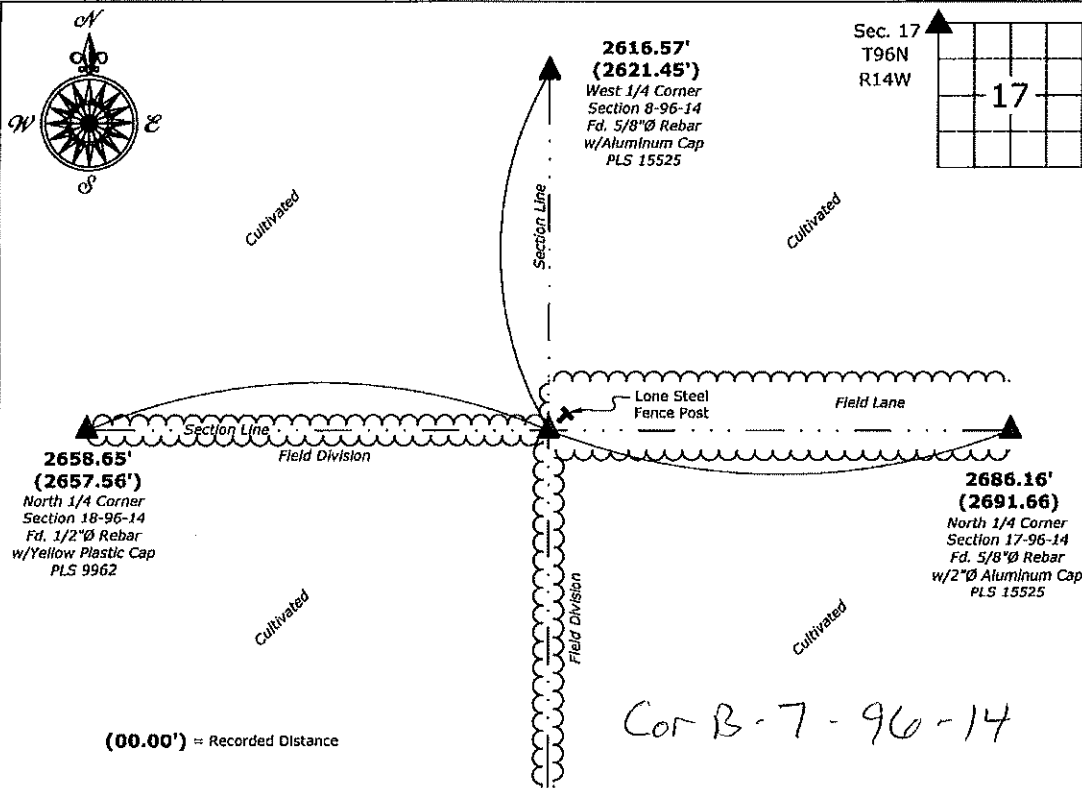

(00.00') = Recorded Distance

Cor B-7-96-14

Northwest Corner of Section 17-96-14
 Set 5/8"Ø Rebar w/2"Ø Aluminum Cap PLS 19211



I hereby certify that this land surveying document was prepared and the related survey work was performed by me or under my direct personal supervision and that I am a duly licensed Land Surveyor under the laws of the State of Iowa.
Kirk D. Reicks 12-30-2020
 Kirk D. Reicks Date:
 License number 19211
 My license renewal date is December 31, 2022.
 Sheets covered by this seal: Individual sheet only

List Corner to be Indexed			
Corner	Section	Twp.	Range
NW	17	96	14
Project Number: 2020-144			
FB: Chickasaw 10, Pgs. 48-49			

File: S:\... Projects - NHO\County Control Systems - NHO\CHICKASAW\CHICK-9\CHICK-9 - 2020.dwg, 12/29/2020 8:31:52 AM