

United States Public Land Survey Corner Certificate

Land Survey Monument situated in
Section **19**, Township **96** North, Range **14** West of the Fifth Principal Meridian, **Chickasaw** County, Iowa.
Not on file in the County Recorder's Office.

This certificate is being prepared in compliance with Iowa Code Chapter 355.11 because:

- ☒ There is no certificate on file for this corner.
☐ There are no longer three valid ties of record.
☐ There are changes to reference ties of record.
☐ There is change of monumentation of record.
☐ To clarify description of record monument (ties).


Monument Description and Remarks:

Center of Section:

Set 5/8"Ø Rebar w/2"Ø Aluminum Cap PLS 19211 on line between the West 1/4 and East 1/4 Corners of said Section at the record distance from the West 1/4 Corner, with information obtained from a Survey and Plat, as recorded in Book 160, Pages 199-202 on file in the County Recorder's Office.

Plan View - Not to Scale

(Show a minimum of three reference ties to durable physical objects, relevant monuments and physical conditions that will enable recovery of the corner.)

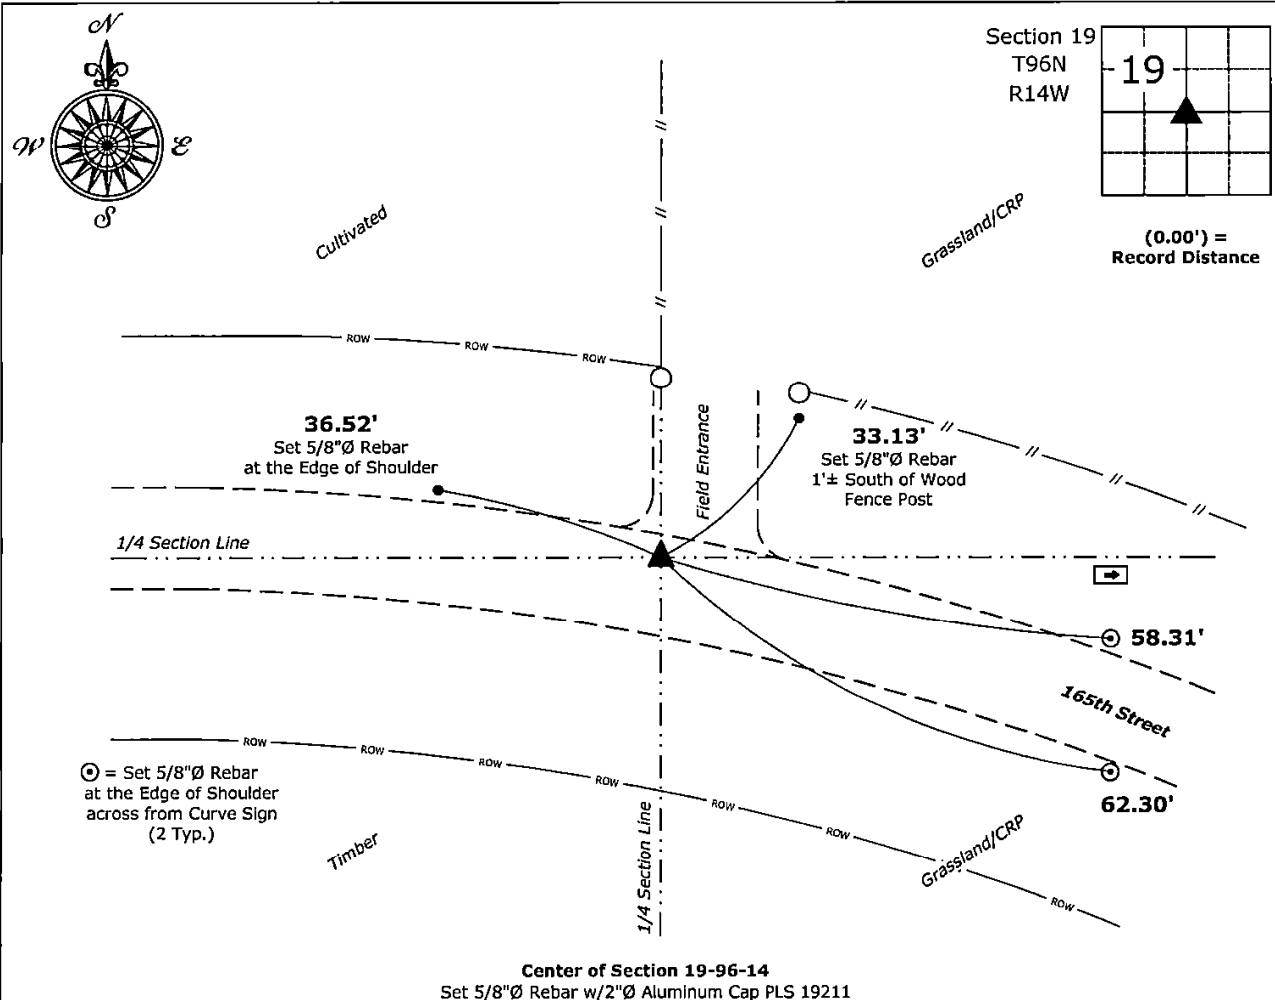

I hereby certify that this land surveying document was prepared and the related survey work was performed by me or under my direct personal supervision and that I am a duly licensed Land Surveyor under the laws of the State of Iowa.

Surveyor under the laws of the State of Iowa.
Kirk D. Reicks 6-17-2026
 Kirk D. Reicks Date:

License Number 19211
My License Renewal Date is December 31, 2026.
Sheets covered by this seal: Individual sheet only

List Corner to be Indexed

Corner	Section	Township	Range
CTR	19	96	14

Project Number: 2026-055

FB: Chickasaw 13, Page(s) 76-78

File: S:_Projects - NHO\County Control Systems\CHICKASAW\CHICK-17\CHICK-17-2026.dwg, 6/17/2026 8:04:41 AM