

United States Public Land Survey Corner Certificate

Land Survey Monument situated in
Section **19**, Township **96** North, Range **14** West of the Fifth Principal Meridian, **Chickasaw** County, Iowa.
On file in **Document #2011-0583** in the County Recorder's Office.

This certificate is being prepared in compliance with Iowa Code Chapter 355.11 because:

- ☐ There is no certificate on file for this corner.
☒ There are no longer three valid ties of record.
☐ There are changes to reference ties of record.
☒ There is change of monumentation of record.
☐ To clarify description of record monument (ties).


Monument Description and Remarks:

North 1/4 Corner:

Set 5/8"Ø Rebar w/2"Ø Aluminum Cap PLS 19211 at the Extension of Possession Line Fence from the South, and at Record Distance from the Center of Section with information obtained from a Survey and Plat, as recorded in Book 160, Pages 199-200, on file at the County Recorder's Office. Previous monument and reference ties are missing due to recent clearing and grubbing.

Plan View - Not to Scale

(Show a minimum of three reference ties to durable physical objects, relevant monuments and physical conditions that will enable recovery of the corner.)

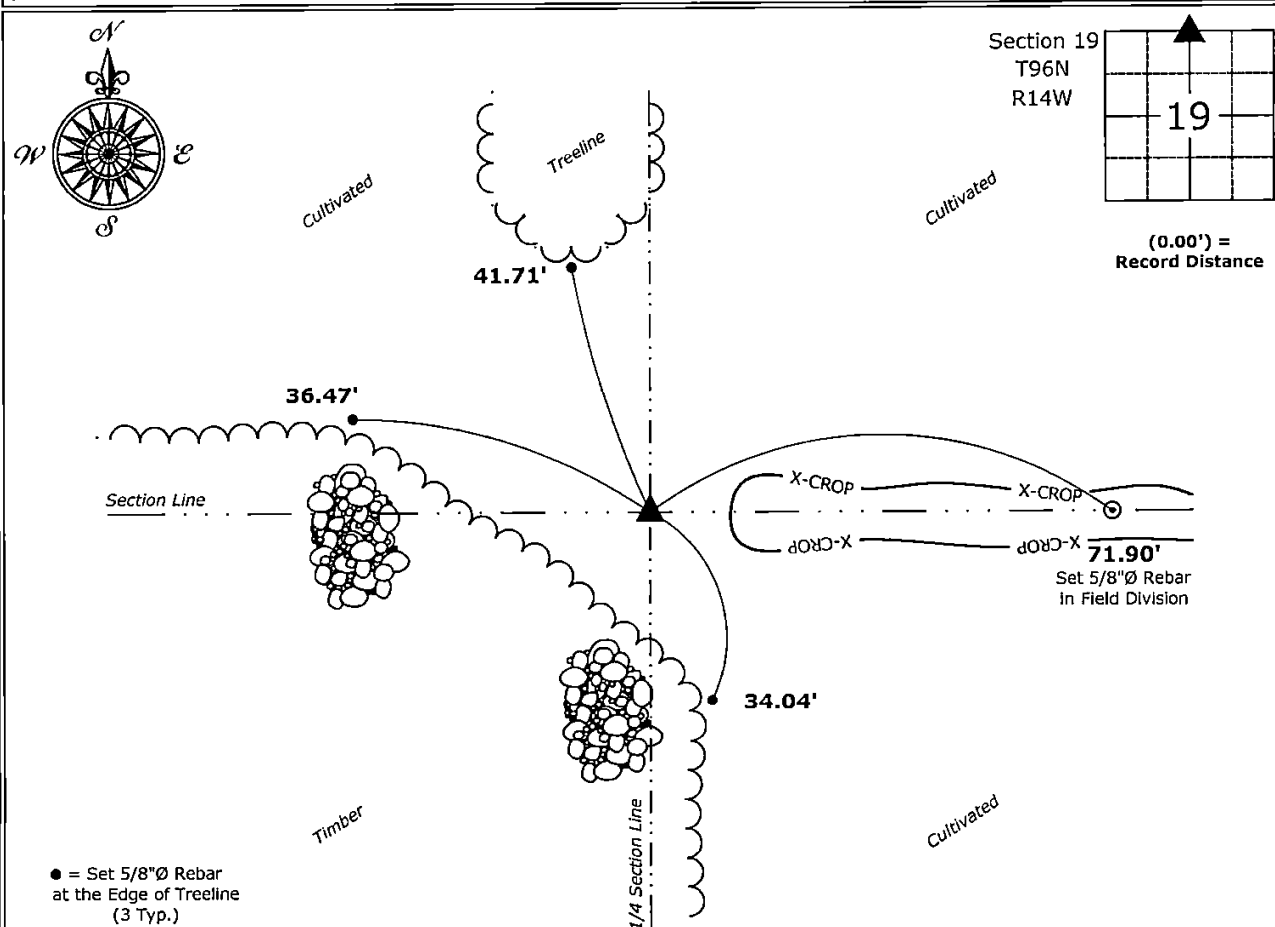

North 1/4 Corner of Section 19-96-14
Set 5/8"Ø Rebar w/2"Ø Aluminum Cap PLS 19211



I hereby certify that this land surveying document was prepared and the related survey work was performed by me or under my direct personal supervision and that I am a duly licensed Land Surveyor under the laws of the State of Iowa.

Kurt D. Stolt 6-17-2026

Kirk D. Reicks

Date:

License Number 19211

My License Renewal Date is December 31, 2026.
Sheets covered by this seal: Individual sheet only

List Corner to be Indexed

Corner	Section	Township	Range
N 1/4	19	96	14

Project Number: 2026-055

FB: Chickasaw 13, Page(s) 76-78

File: S:\Projects - NHO\County Control Systems\CHICKASAW\CHICK-17\CHICK-17-2026.dwg, 6/17/2026 9:38:37 AM