

Prepared by & Return to: *Herold - Reicks Surveying, 10 East Main Street, New Hampton, IA 50658, Ph. 641-384-2725*

**UNITED STATES PUBLIC LAND SURVEY CORNER CERTIFICATE**

Land Survey Monuments situated in Section <sup>16</sup> 21, Township 96 North, Range 14 West of the Fifth Principal Meridian, Chickasaw County, Iowa. 1., 2.) Not previously recorded in the County Recorder's office.

This certificate is being prepared in compliance with Iowa Code Chapter 355.11 because:



- 1 & 2 There is no certificate on file for this corner.
- There are no longer three valid ties of record.
- There are changes to reference ties of record.
- There is change of monumentation of record.
- To clarify description of record monument (ties).

Monument Description and Remarks:

- 1.) **West 1/4 Corner:** Found 1/2"Ø Iron pin with information obtained from the County Engineer's Office.
- 2.) **North 1/4 Corner:** Calculated position at the intersection of a line from the North 1/4 of Section 16-T96N-R14W through a possession line fence at the Northeast Corner SE 1/4-SW 1/4 and a line from the Northeast Corner of Section 21-T96N-R14W through a found monument at a Northeast corner of Parcel "A". Position falls in river. Set monuments North and South online as witnesses to the corner.

**PLAN - VIEW**

(Show a minimum of three reference ties to durable physical objects, relevant monuments and physical conditions that will enable recovery of the corner.)

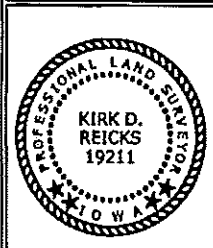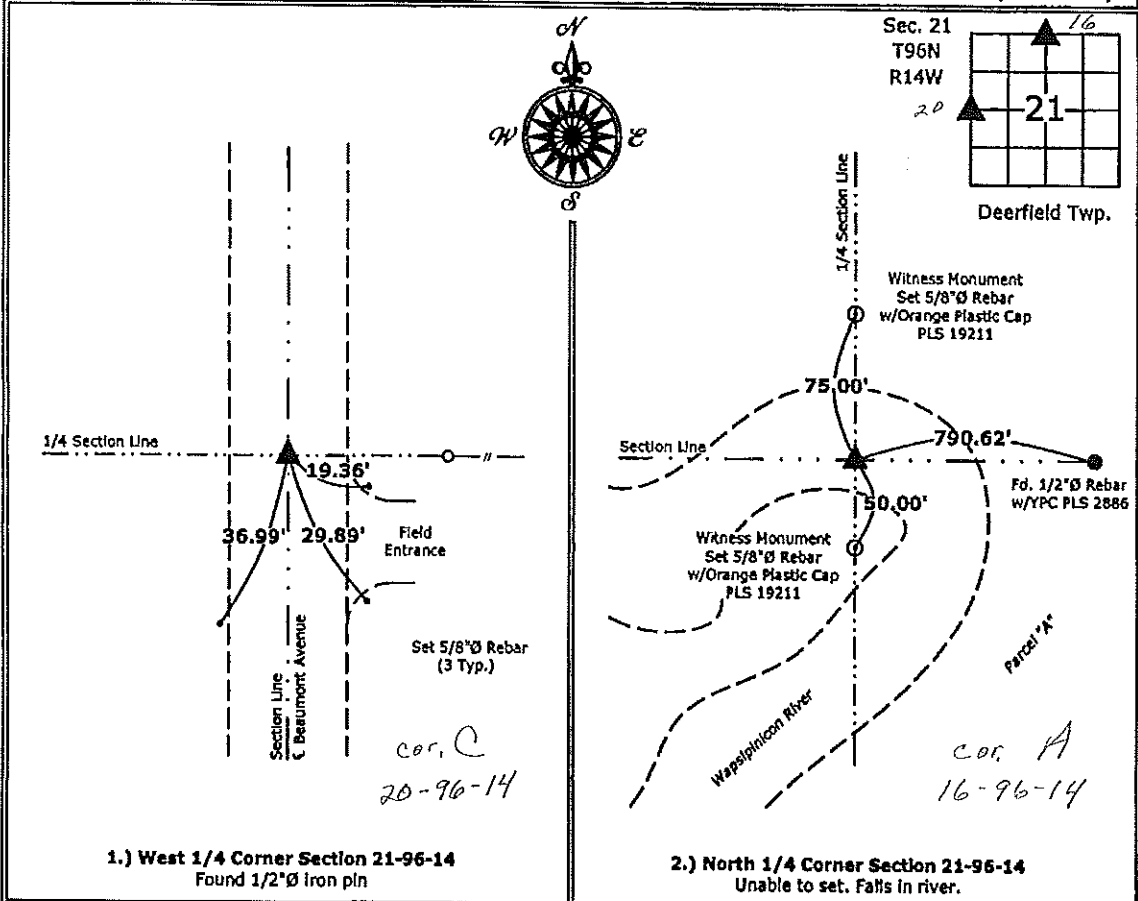

I hereby certify that this land surveying document was prepared and the related survey work was performed by me or under my direct personal supervision and that I am a duly licensed Land Surveyor under the laws of the State of Iowa.

*Kirk D. Reicks 2-4-13*  
 Kirk D. Reicks Date:  
 License number 19211  
 My license renewal date is December 31, 2014.  
 Sheets covered by this seal: Individual sheet only

List Corners to be Indexed			
Corners	Section	Twp.	Range
W 1/4	21	96	14
N 1/4	21	96	14

FB: Chickasaw 5, Pgs. 24-25  
 Survey was completed on January 14, 2013.