

Chickasaw Co. Recorder
Cindy Messersmith
Fee Book 2015-0857
07/06/2015 00318PM
SSC SEC COR CERT
Book: Page: # Pages: 1
Total Fees: \$7.00

Prepared by & Return to: Herold - Reicks Surveying, 10 East Main Street, New Hampton, IA 50659, Ph. 641-394-2725

UNITED STATES PUBLIC LAND SURVEY CORNER CERTIFICATE

Land Survey Monuments situated in Section 22, Township 96 North, Range 14 West of the Fifth Principal Meridian, **Chickasaw** County, Iowa. Not previously recorded in the County Recorder's office.

This certificate is being prepared in compliance with Iowa Code Chapter 355.11 because:


- There is no certificate on file for this corner.
- There are no longer three valid ties of record.
- There are changes to reference ties of record.
- There is change of monumentation of record.
- To clarify description of record monument (ties).

Monument Description and Remarks:

Northeast Corner: Fd. 1/2"Ø rebar w/3"Ø Aluminum Cap PLS 11442 with information obtained from a Survey and Plat made by L. P. Erdman, recorded in Book 137, Pages 360-361 on file in the County Recorder's office.

PLAN - VIEW

(Show a minimum of three reference ties to durable physical objects, relevant monuments and physical conditions that will enable recovery of the corner.)

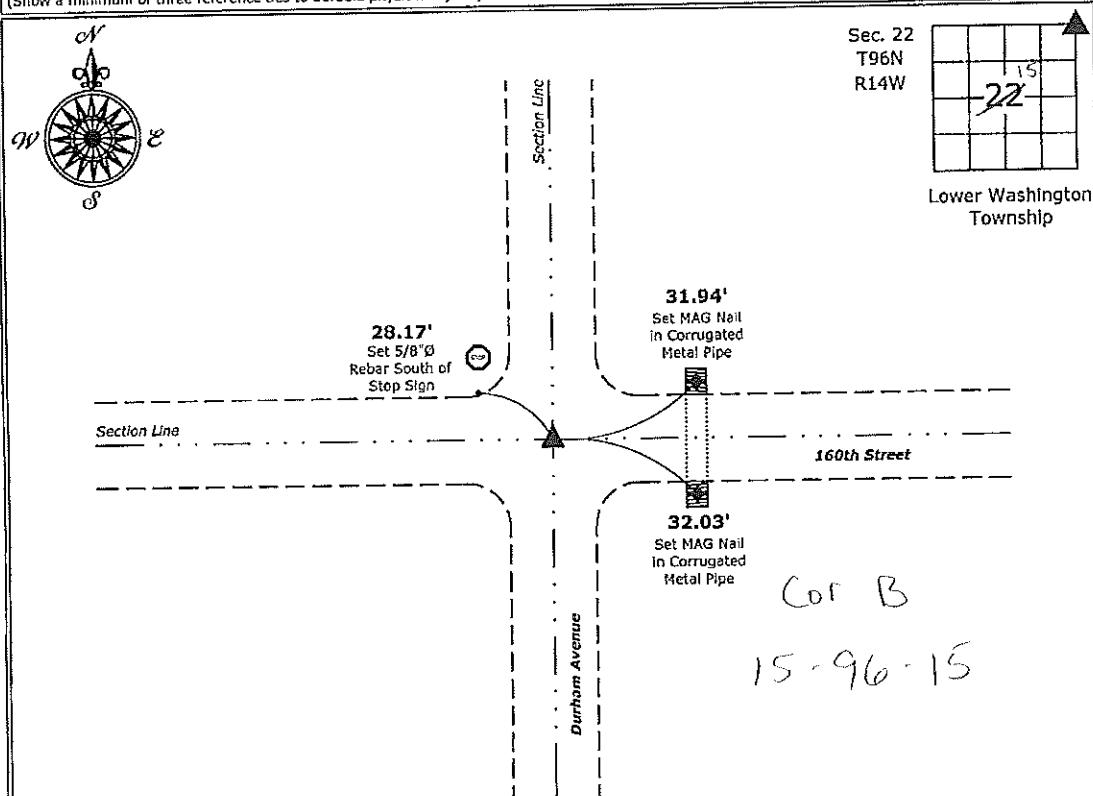

Northeast Corner Section 22-96-14
Fd. 1/2"Ø rebar w/3"Ø Aluminum Cap PLS 11442



I hereby certify that this land surveying document was prepared and the related survey work was performed by me or under my direct personal supervision and that I am a duly licensed Land Surveyor under the laws of the State of Iowa.

Kirk D. Reicks 7-6-15
Kirk D. Reicks Date:

License number 19211

My license renewal date is December 31, 2016.
Sheets covered by this seal: Individual sheet only

List Corners to be Indexed

Corners	Section	Twp.	Range
NE	22	96	14

Project Number: 2014-258

FB: Chickasaw County 7, Pgs. 37-38