

Prepared by & Return to: Herold - Reicks Surveying, 10 East Main Street, New Hampton, IA 50659, Ph. 641-354-0125

UNITED STATES PUBLIC LAND SURVEY CORNER CERTIFICATE

Land Survey Monuments situated in Section 29, Township 96 North, Range 14 West of the Fifth Principal Meridian, Chickasaw County, Iowa. 1., 2.) Not previously recorded in the County Recorder's office.

This certificate is being prepared in compliance with Iowa Code Chapter 355.11 because:

- 1 & 2 There is no certificate on file for this corner.
 There are no longer three valid ties of record.
 There are changes to reference ties of record.
 There is change of monumentation of record.
 To clarify description of record monument (ties).


Monument Description and Remarks:

1.) West 1/4 Corner: Set 5/8"Ø rebar w/2"Ø aluminum cap PLS 15525 at the base of a 2"Ø Steel Corner Post (Bent). Position recovered from a Survey and Plat made by Terry D. Van Laningham, recorded on July 11, 2007 in Document #2007-1421, on file in the Chickasaw County Recorder's office, New Hampton, Iowa.

2.) Center: Set 5/8"Ø rebar w/2"Ø aluminum cap PLS 15525 at the intersection of 1/4 Section Lines; there is no record of the perpetuation of a monument at this Corner.


PLAN - VIEW

(Show a minimum of three reference ties to durable physical objects, relevant monuments and physical conditions that will enable recovery of the corner.)

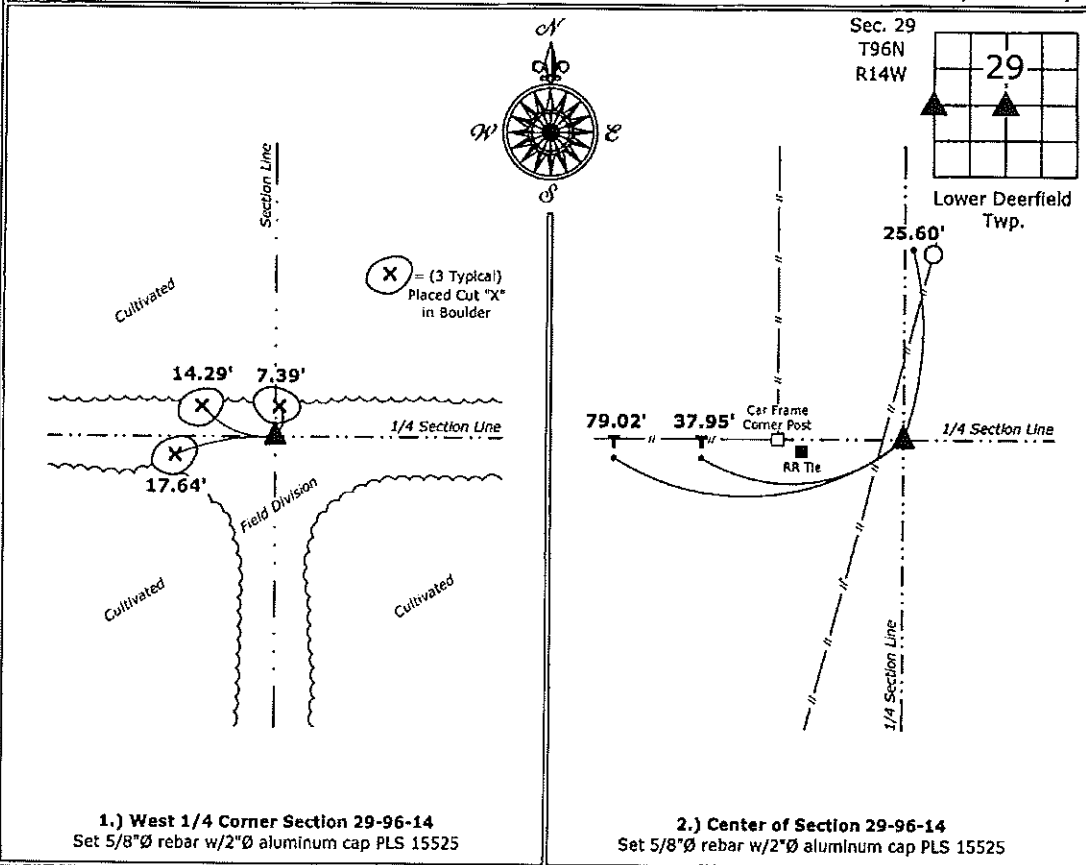

1.) West 1/4 Corner Section 29-96-14
 Set 5/8"Ø rebar w/2"Ø aluminum cap PLS 15525

2.) Center of Section 29-96-14
 Set 5/8"Ø rebar w/2"Ø aluminum cap PLS 15525

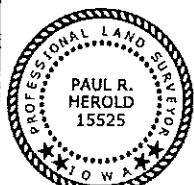

I hereby certify that this land surveying document was prepared and the related survey work was performed by me or under my direct personal supervision and that I am a duly licensed Land Surveyor under the laws of the State of Iowa.

Paul R. Herold 8-26-14
 Paul R. Herold Date:
 License number 15525
 My license renewal date is December 31, 2014.
 Sheets covered by this seal: Individual sheet only

List Corners to be Indexed

Corners	Section	Twp.	Range
W 1/4	29	96	14
CTR	29	96	14

Project Number: 2014-155

FB: Chickasaw County 7, Pgs. 1-5

File: S:_C3D Projects\County Control Systems\CHICKASAW\CHICK-17\CHICK-17.dwg, 8/25/2014 2:59:47 PM