

Prepared by & Return to: Kirk D. Reicks, HRS, LLC, 10 East Main Street, New Hampton, IA 50659, Phone 641-394-2725

United States Public Land Survey Corner Certificate

Land Survey Monument situated in
Section 19, Township 96 North, Range 14 West of the Fifth Principal Meridian, Chickasaw County, Iowa.
On file in Book 154, Page 425 in the County Recorder's Office.

This certificate is being prepared in compliance with Iowa Code Chapter 355.11 because:

☐ There is no certificate on file for this corner.
☒ There are no longer three valid ties of record.
☒ There are changes to reference ties of record.
☒ There is change of monumentation of record.
☐ To clarify description of record monument (ties).


Monument Description and Remarks:

Southwest Corner of the SE 1/4 - SE 1/4:

Found 1/2"Ø Rebar w/Yellow Plastic Cap Remnants with information obtained from the Chickasaw County Engineer's Office, in Field Book Deerfield Township Ties to Corners, Section 19, Corner A1.

Plan View - Not to Scale

(Show a minimum of three reference ties to durable physical objects, relevant monuments and physical conditions that will enable recovery of the corner.)

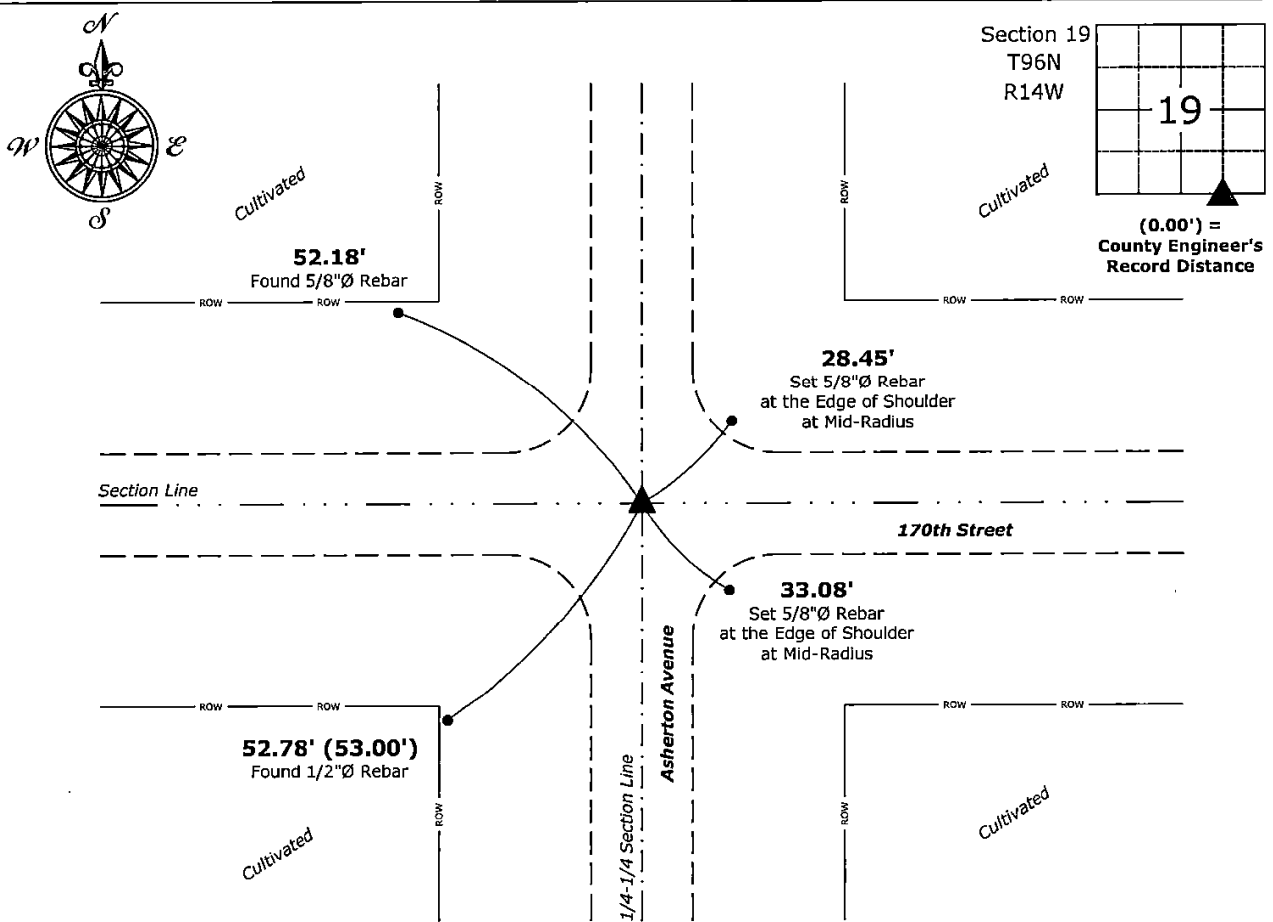

Southwest Corner of the SE 1/4 - SE 1/4 of Section 19-96-14
Found 1/2"Ø Rebar w/Yellow Plastic Cap Remnants



I hereby certify that this land surveying document was prepared and the related survey work was performed by me or under my direct personal supervision and that I am a duly licensed Land Surveyor, under the laws of the State of Iowa.
Kirk D. Reicks 6-17-2026
Kirk D. Reicks Date:
License Number 19211
My License Renewal Date is December 31, 2026.
Sheets covered by this seal: Individual sheet only

List Corner to be Indexed			
Corner	Section	Township	Range
SW-SE-SE	19	96	14
Project Number: 2026-055			
FB: Chickasaw 13, Page(s) 76-78			

File: S:_Projects - NHO\County Control Systems\CHICKASAW\CHICK-17\CHICK-17-2026.dwg, 6/17/2026 8:03:07 AM