

Prepared by & Return to: Herold - Reicks Surveying, 10 East Main Street, New Hampton, IA 50659, Ph. 641-394-2725

UNITED STATES PUBLIC LAND SURVEY CORNER CERTIFICATE

Land Survey Monuments situated in Section **29**, Township **96** North, Range **14** West of the Fifth Principal Meridian, **Chickasaw** County, Iowa. **1., 2.)** Not previously recorded in the County Recorder's office.

This certificate is being prepared in compliance with Iowa Code Chapter 355.11 because:

- 1 & 2 There is no certificate on file for this corner.
 There are no longer three valid ties of record.
 There are changes to reference ties of record.
 There is change of monumentation of record.
 To clarify description of record monument (ties).


Monument Description and Remarks:

1.) Northwest Corner: Fd. 5/8"Ø rebar from information obtained from a Survey and Plat made by Terry D. Van Laningham, recorded on July 11, 2007 in Document #2007-1421, on file in the Chickasaw County Recorder's office, New Hampton, Iowa.

2.) North 1/4 Corner: Set 5/8"Ø rebar w/2"Ø aluminum cap PLS 15525 at the intersection of a possession line fence to the South and the Centerline of 170th Street.

PLAN - VIEW

(Show a minimum of three reference ties to durable physical objects, relevant monuments and physical conditions that will enable recovery of the corner.)

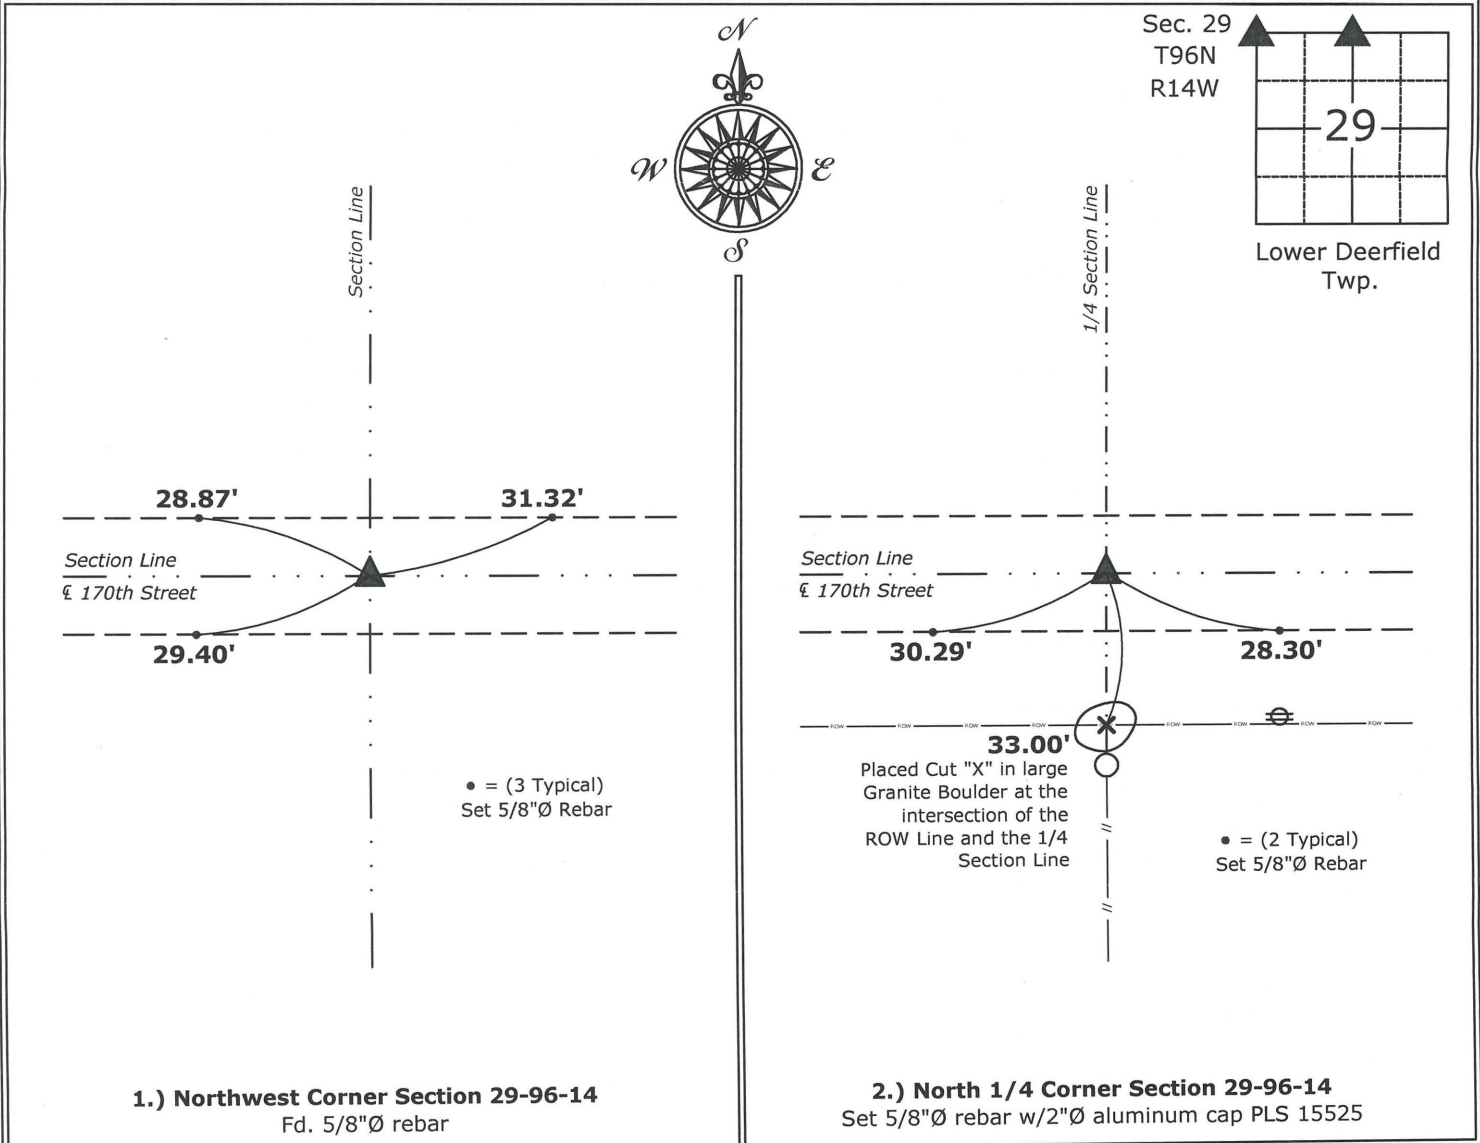

I hereby certify that this land surveying document was prepared and the related survey work was performed by me or under my direct personal supervision and that I am a duly licensed Land Surveyor under the laws of the State of Iowa.

Paul R. Herold 8-26-14
 Paul R. Herold Date:
 License number 15525
 My license renewal date is December 31, 2014.
 Sheets covered by this seal: Individual sheet only

List Corners to be Indexed			
Corners	Section	Twp.	Range
NW	29	96	14
N 1/4	29	96	14

Project Number: 2014-155
 FB: Chickasaw County 7, Pgs. 1-5