

[illegible]

# United States Public Land Survey Corner Certificate

Land Survey Monument situated in  
Section **33**, Township **96** North, Range **14** West of the Fifth Principal Meridian, **Chickasaw** County, Iowa.  
On file in **Document #2011-1964** in the County Recorder's Office.

This certificate is being prepared in compliance with Iowa Code Chapter 355.11 because:

- ☐ There is no certificate on file for this corner.  
☐ There are no longer three valid ties of record.  
☒ There are changes to reference ties of record.  
☒ There is change of monumentation of record.  
☐ To clarify description of record monument (ties).



**Monument Description and Remarks:**

**West 1/4 Corner:**

Found 3/4"Ø Rebar (cap missing) with information obtained from the previously recorded Section Corner Certificate.

### Plan View - Not to Scale

(Show a minimum of three reference ties to durable physical objects, relevant monuments and physical conditions that will enable recovery of the corner.)

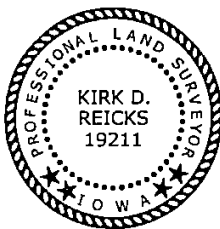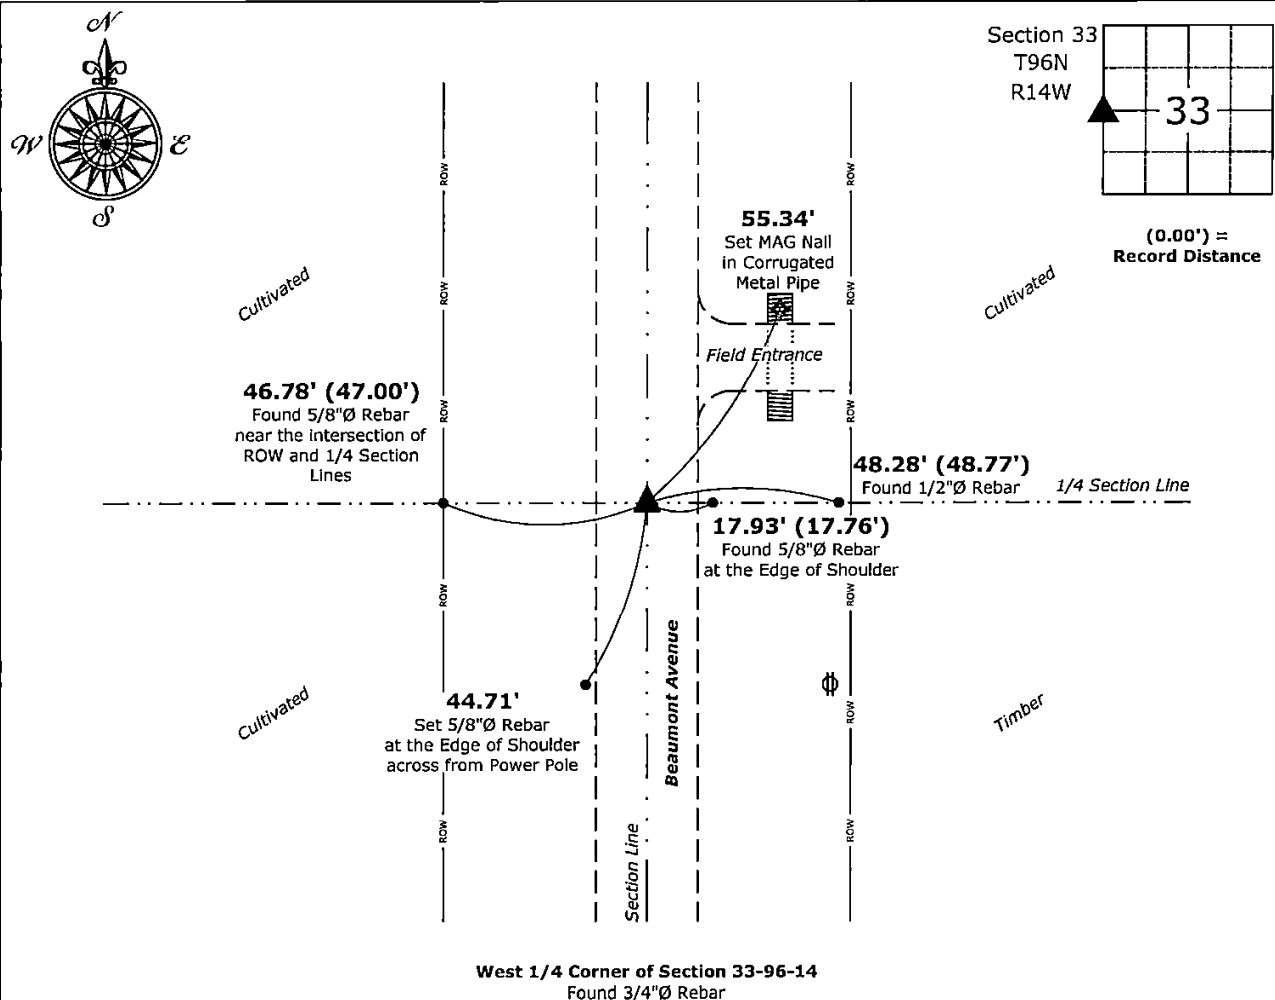

I hereby certify that this land surveying document was prepared and the related survey work was performed by me or under my direct personal supervision and that I am a duly licensed Land Surveyor under the laws of the State of Iowa.

Kurt D. Thiele 6-5-2026

---

Kirk D. Reicks

Date:

License Number 19211

My License Renewal Date is December 31, 2026.

Sheets covered by this seal: Individual sheet only

## List Corner to be Indexed

|        |         |          |       |
|--------|---------|----------|-------|
| Corner | Section | Township | Range |
| W 1/4  | 33      | 96       | 14    |

Project Number: 2026-051

FB: Chickasaw 13, Page(s) 73-74

File: S:\\_\_Projects - NHO\County Control Systems\CHICKASAW\CHICK-17\CHICK-17-2026.dwg, 6/5/2026 8:15:45 AM