

Section 33-96-14  
As referred to in  
Eng. Tax Book

Chickasaw Co. Recorder  
Cindy Messersmith  
Fee Book 2009-0065  
01/08/2009 @1003AM  
SCC: SEC COR CERT  
Book: Page: #. Pages: 1  
Total Fees: \$7.00

PREPARED BY KENNETH D. STARK 1622 SOUTH TAFT AVENUE, MASON CITY, IOWA 50401 (641) 423-7947

**UNITED STATES PUBLIC LAND SURVEY CORNER CERTIFICATE**

OF  
LAND SURVEY MONUMENTS SITUATED IN SECTION 34: TOWNSHIP 96N. RANGE 14W. OF THE 5th PRINCIPAL MERIDIAN  
CHICKASAW COUNTY, IOWA PREVIOUSLY RECORDED IN (NOT APPLICABLE) IN COUNTY RECORDER'S OFFICE.


MONUMENT DESCRIPTION AND REMARKS:

NW COR SW 1/4 NW 1/4 - SET 1/2" REBAR/YELLOW PLASTIC CAP 10898 2" DEEP MONUMENT ONLINE FROM NW COR AND W 1/4 COR


REASON FOR CERT: NO CERT OF RECORD

**PLAN VIEW**

NW COR SW 1/4 NW 1/4

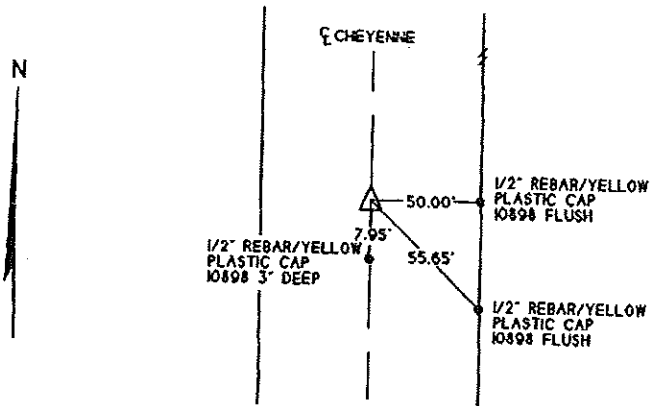

cor C1  
33-96-14

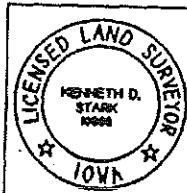

I HEREBY HEREBY CERTIFY THAT THIS LAND SURVEYING DOCUMENT WAS PREPARED AND THE RELATED SURVEY WAS PERFORMED BY ME OR UNDER MY PERSONAL SUPERVISION AND THAT I AM A DULY LICENSED SURVEYOR.

*Kenneth D. Stark*  
KENNETH D. STARK  
12-31-00  
DATE

LICENSE NUMBER 10999  
MY LICENSE RENEWAL DATE IS DECEMBER 31, 2009  
PAGE(S) OR SHEET(S) COVERED BY THIS SEAL: 1

LIST OF CORNERS TO BE INDEXED			
CORNERS	SECTION	TWP	RANGE
NW COR SW 1/4 NW 1/4	34	96	14

