

Section 33-96-14
 As referred to in
 Eng. Tie Book.

Chickasaw Co. Recorder
 Cindy Messersmith
Fee Book 2009-0064
 01/08/2009 @1002AM
 SCC SEC COR CERT
 Book: Page: # Pages: 1
 Total Fees: \$7.00

PREPARED BY KENNETH D. STARK 1822 SOUTH TAFT AVENUE, MASON CITY, IOWA 50401 (641) 423-7947

UNITED STATES PUBLIC LAND SURVEY CORNER CERTIFICATE
 OF

LAND SURVEY MONUMENTS SITUATED IN SECTION 34, TOWNSHIP 96N, RANGE 14W, OF THE 5th PRINCIPAL MERIDIAN
 CHICKASAW COUNTY, IOWA PREVIOUSLY RECORDED IN (NOT APPLICABLE) IN COUNTY RECORDER'S OFFICE.


MONUMENT DESCRIPTION AND REMARKS:

W 1/4 COR - FOUND 600 NAIL 2" DEEP 62.3' WEST OF REFERENCE PIN PER COUNTY ENGINEER'S RECORD

REASON FOR CERT: NO CERT OF RECORD

PLAN VIEW


W 1/4 COR

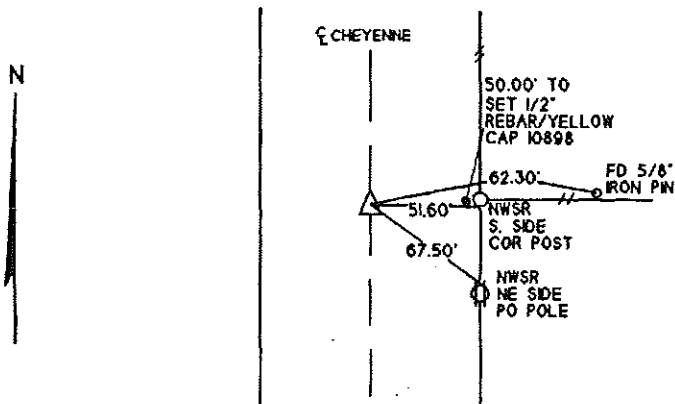

cor. C
 33-96-14

LIST OF CORNERS TO BE INDEXED

CORNERS	SECTION	TWP	RANGE
W 1/4 COR	34	96	14

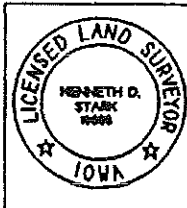

I HEREBY HEREBY CERTIFY THAT THIS LAND SURVEYING DOCUMENT WAS
 PREPARED AND THE RELATED SURVEY WAS PERFORMED BY ME
 OR UNDER MY PERSONAL SUPERVISION AND THAT I AM A DULY
Kenneth D. Stark 12-31-08
 KENNETH D. STARK DATE
 LICENSE NUMBER 10494
 MY LICENSE RENEWAL DATE IS DECEMBER 31, 2009
 PAGES OR SHEETS COVERED BY THIS SEAL 1

