

[illegible]

United States Public Land Survey Corner Certificate

Land Survey Monument situated in
Section **33**, Township **96** North, Range **14** West of the Fifth Principal Meridian, **Chickasaw** County, Iowa.
Not on file in the County Recorder's Office.

This certificate is being prepared in compliance with Iowa Code Chapter 355.11 because:

- ☒ There is no certificate on file for this corner.
☐ There are no longer three valid ties of record.
☐ There are changes to reference ties of record.
☐ There is change of monumentation of record.
☐ To clarify description of record monument (ties).


Monument Description and Remarks:

North 1/4 Corner:


Set 5/8"Ø Rebar w/2"Ø Aluminum Cap PLS 19211, 33.00' South of a found angle Iron corner post with information obtained from the Chickasaw County Engineer's Office, in Field Book Deerfield Township Ties to Corners, Section 28, Corner A.

Plan View - Not to Scale

(Show a minimum of three reference ties to durable physical objects, relevant monuments and physical conditions that will enable recovery of the corner.)

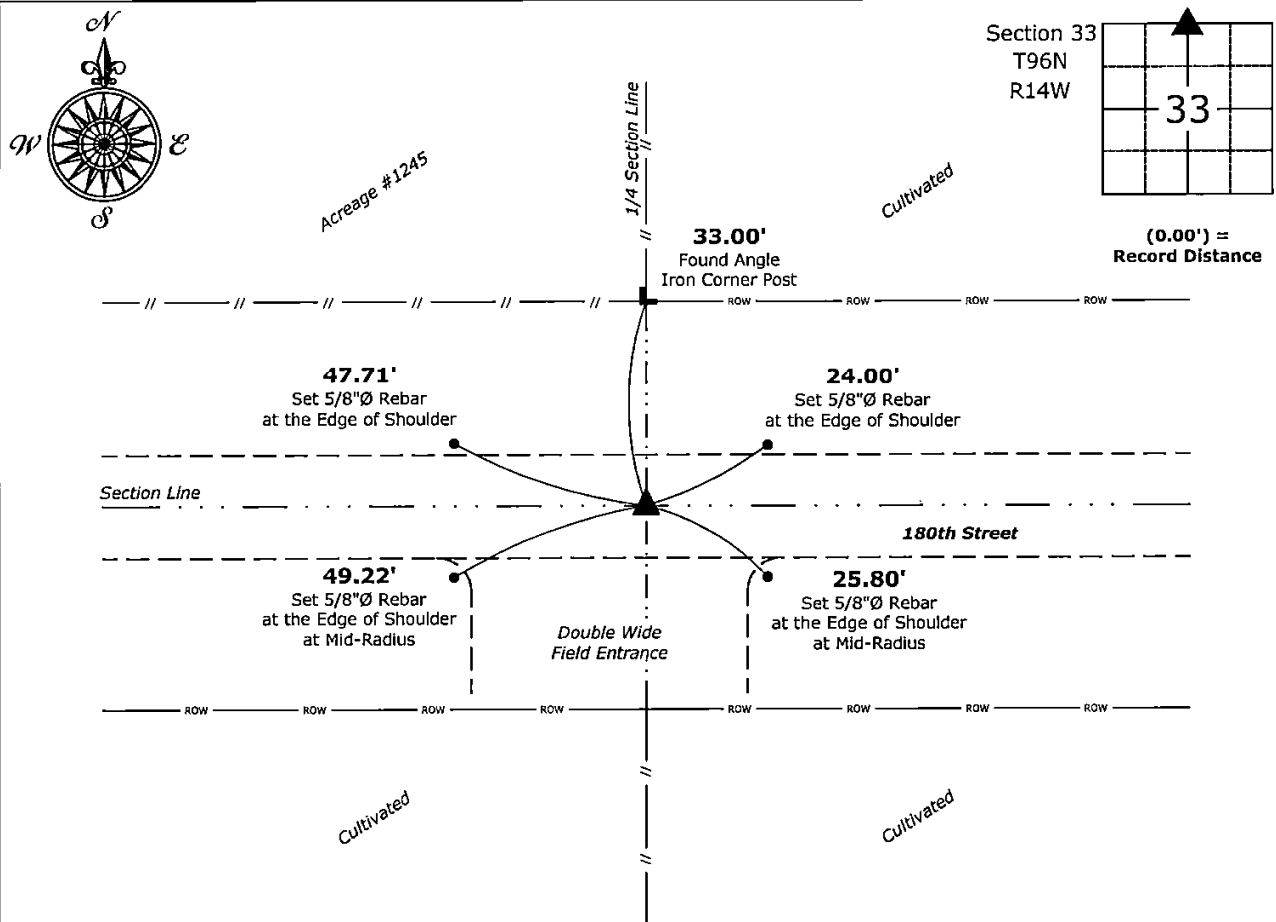

North 1/4 Corner of Section 33-96-14
Set 5/8"Ø Rebar w/2"Ø Aluminum Cap PLS 19211

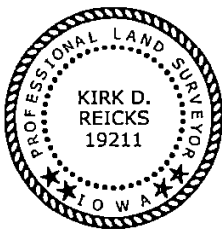

I hereby certify that this land surveying document was prepared and the related survey work was performed by me or under my direct personal supervision and that I am a duly licensed Land Surveyor under the laws of the State of Iowa.

Kirk D. Reicks 6-5-2026
Kirk D. Reicks Date:

License Number 19211
My License Renewal Date is December 31, 2026.
Sheets covered by this seal: Individual sheet only

List Corner to be Indexed

Corner	Section	Township	Range
N 1/4	33	96	14

Project Number: 2026-051

FB: Chickasaw 13, Page(s) 73-74