

Section 28-96-14
As referred to in
Engr. Tie Book

Chickasaw Co. Recorder
Cindy Messersmith
Fee Book 2009-0063

01/08/2009 @1001AM
SCC SEC COR CERT # Pages: 1
Book: Page: \$7.00
Total Fees:

PREPARED BY KENNETH D. STARK 1622 SOUTH TAFT AVENUE, MASON CITY, IOWA 50401 (640) 423-7947

UNITED STATES PUBLIC LAND SURVEY CORNER CERTIFICATE
OF


LAND SURVEY MONUMENTS SITUATED IN SECTION 34, TOWNSHIP 96N, RANGE 14W, OF THE 5th PRINCIPAL MERIDIAN
CHICKASAW COUNTY, IOWA PREVIOUSLY RECORDED IN (NOT APPLICABLE) IN COUNTY RECORDER'S OFFICE.

MONUMENT DESCRIPTION AND REMARKS:


NW COR - FOUND 1/2" REBAR 3" DEEP PER COUNTY ENGINEER'S RECORD

REASON FOR CERT: NO CERT OF RECORD

PLAN VIEW

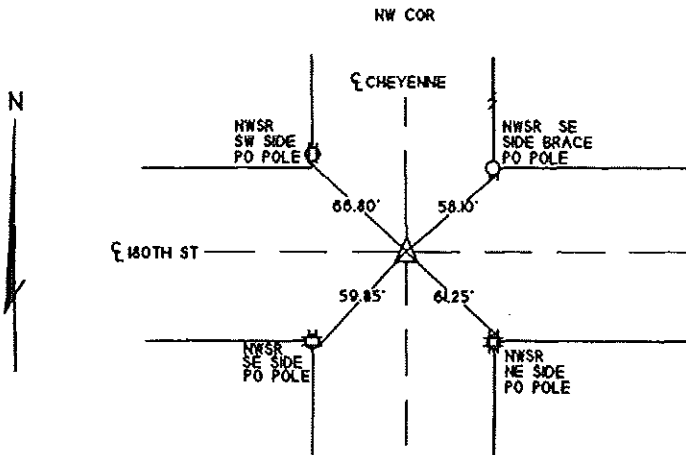

cor. B
28-96-14

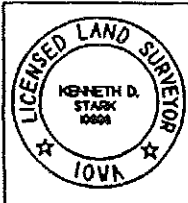

I HEREBY HEREBY CERTIFY THAT THIS LAND SURVEYING DOCUMENT WAS
PREPARED AND THE RELATED SURVEY WAS PERFORMED BY ME
OR UNDER MY PERSONAL SUPERVISION AND THAT I AM A DULY

Kenneth D. Stark 12-31-09
KENNETH D. STARK DATE
LICENSE NUMBER 10499
MY LICENSE RENEWAL DATE IS DECEMBER 3, 2009
PAGES OR SHEETS COVERED BY THIS SEAL 1

LIST OF CORNERS TO BE INDEXED			
CORNERS	SECTION	TWP	RANGE
NW COR	34	96	14

