

Section 27-96-14  
As referred to in  
Engr. The Book

TEKIPPE ENGINEERING, P.C., 128 South Vine Street, West Union, Iowa 52175 Phone (319) 422-5131

UNITED STATES PUBLIC LAND SURVEY CORNER CERTIFICATE

OF 27  
Land Survey Monuments situated in Section 34, Township 96 North, Range 14 West of the Fifth Principal Meridian, CHICKASAW County, Iowa.  
Previously recorded in none in County Recorder's Office.  
(book, page, document number, etc.)


(Show reason for preparing this certificate, the evidence and detailed procedures used in establishing the corner positions and monumentation found or placed.)

Monument Description and Remarks: N 1/4 Corner Section 34 T96N R14W: Found 1/2"Ø pin, 2.5' deep, in old road bed, with information obtained from the Chickasaw County Engineer's Office in the Field Book Deerfield Twp. Corner Ties, Corner 'A', Section 27. Set 1/2"Ø rebar w/2"Ø aluminum cap LS 7060 over the pin.  
NE Corner Section 34 T96N R14W: Found 1/2"Ø rebar with information obtained from the Chickasaw County Engineer's Office in the Field Book Deerfield Twp. Corner Ties, Corner 'B', Section 27.

PLAN - VIEW


Project Number 00228.LS  
FB 48H PG. 33-34

(Show a minimum of three reference ties to durable physical objects, relevant monuments and physical conditions that will enable recovery of the corner.)

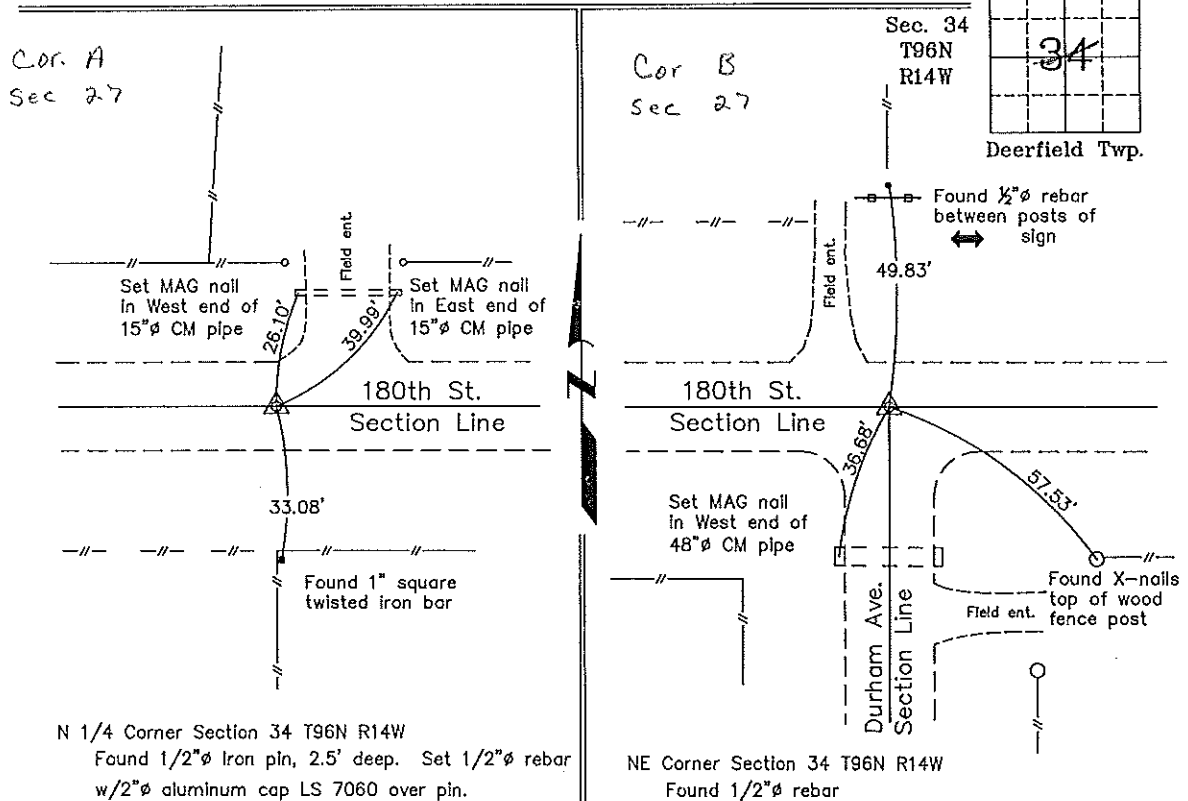

N 1/4 Corner Section 34 T96N R14W  
Found 1/2"Ø Iron pin, 2.5' deep. Set 1/2"Ø rebar w/2"Ø aluminum cap LS 7060 over pin.

NE Corner Section 34 T96N R14W  
Found 1/2"Ø rebar

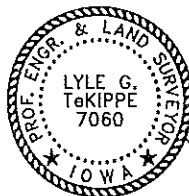

I hereby certify that this land surveying document was prepared and the related survey work was performed by me or under my direct personal supervision and that I am a duly licensed Land Surveyor under the laws of the State of Iowa.

*Lyle G. Tekippe* 10-24-00  
Lyle G. Tekippe Date  
License number 7060  
My license renewal date is December 31, 2000.  
Sheets covered by this seal: Individual

List Corners to be Indexed			
Corners	Section	Twp.	Range
N 1/4	34	96N	14W
A	27		
NE	34	96N	14W
B	27		

2000-1896

Filed 10-27-00