

Chickasaw Co. Recorder
 Cindy Messersmith
Fee Book 2009-0068
 01/08/2009 00404PM
 SCC SEC COR CERT
 Book: Page: # Pages: 1
 Total Fees: \$7.00

PREPARED BY KENNETH D. STARK 1622 SOUTH TAFT AVENUE, MASON CITY, IOWA 50401 (640) 423-7947

UNITED STATES PUBLIC LAND SURVEY CORNER CERTIFICATE
 OF

LAND SURVEY MONUMENTS SITUATED IN SECTION 34, TOWNSHIP 96N, RANGE 14W, OF THE 5th PRINCIPAL MERIDIAN
 CHICKASAW COUNTY, IOWA PREVIOUSLY RECORDED IN (NOT APPLICABLE) IN COUNTY RECORDER'S OFFICE.

MONUMENT DESCRIPTION AND REMARKS:


NE COR SE 1/4 NW 1/4 - SET 1/2" REBAR/YELLOW PLASTIC CAP 10898 2" EXPOSED

MIDPOINT ONLINE FROM N 1/4 COR & CENTER

REASON FOR CERT: NO CERT OF RECORD

PLAN VIEW


NE COR SE 1/4 NW 1/4

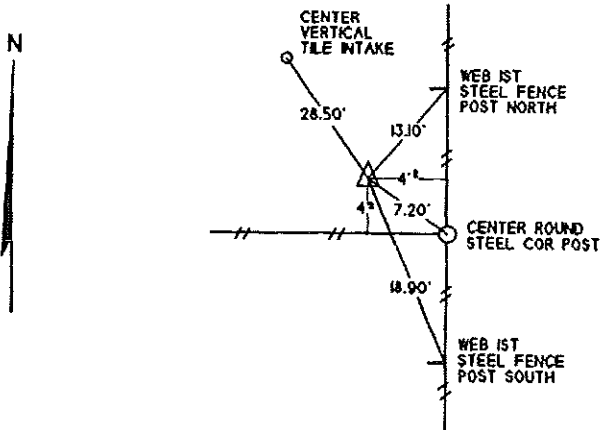

Cor. Y

LIST OF CORNERS TO BE INDEXED

CORNERS	SECTION	TWP	RANGE
NE COR SE 1/4 NW 1/4	34	96	14

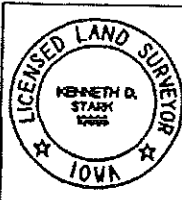

I HEREBY CERTIFY THAT THIS LAND SURVEYING DOCUMENT WAS
 PREPARED AND THE RELATED SURVEY WAS PERFORMED BY ME
 OR UNDER MY PERSONAL SUPERVISION THAT I AM A DULY

Kenneth D. Stark 12-31-08
 KENNETH D. STARK DATE

LICENSE NUMBER 10999
 MY LICENSE RENEWAL DATE IS DECEMBER 31, 2009
 PAGES OR SHEETS COVERED BY THIS SEAL 1

