
COUNTY ENGINEER'S SECTION CORNER PRESERVATION RECORD

LAND SURVEY MONUMENT LOCATED IN SECTION 35, TOWNSHIP 96 N NORTH, RANGE 14 W , OF THE 5TH P.M. Chickgsqw county, IOWA PREVIOUSLY RECORDED FILE 2008-0171

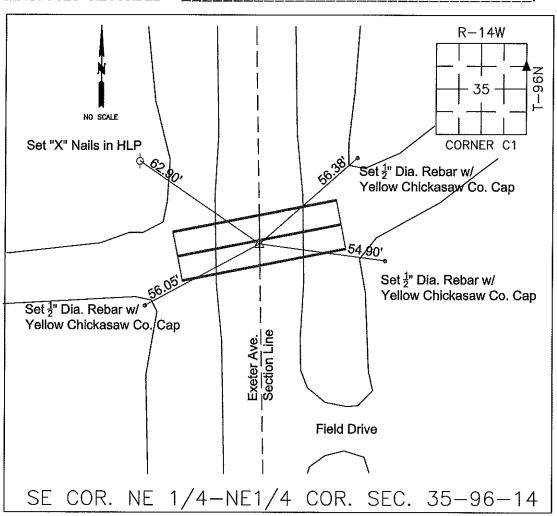

MONUMENT DESCRIPTION AND NARRATIVE

Previous Section Corner (5/8" Dia. Rebar w/ 2"

Aluminum Cap — PLS15525) was removed during bridge replacement (Former FHWA BR#112945, Current FHWA BR#112946). Set 1/2" Dia. Rebar w/ yellow Chickasaw Co. Cap in position of previous Section Corner.

All ties are GPS surveyed.

I AM NOT A REGISTERED LAND SURVEYOR UNDER THE LAWS OF THE STATE OF IOWA

ROMAN LENSING CHICKASAW COUNTY DATE: 10/03/2018

Herold - Reicks Surveying, 25 1/2 East Main Street; Suite 204, New Hampton, IA 50659, Ph. 64-394-2725 UNITED STATES PUBLIC LAND SURVEY CORNER CERTIFICATE Land Survey Monuments situated in: 35 , Township 96 North, Range 14 West of the Fifth Principal Meridian, None County, Iowa. Previously recorded in <u>Chickasaw</u> ok, page, document number, etc.) in County Recorder's Office. (Show reason for preparing this certificate, the evidence and detailed procedures used in establishing the corner positions and monumentation found or placed.) Monument Description and Remarks: E 1/4 Corner Section 35-96-14: Set 5/8"Ø rebar w/2"Ø aluminum cap PLS 15525 from the 2 remaining ties obtained from the County Engineer's Office in Field Book Lower Deerfield Twp. Corner Ties, Section 35, Corner "C" SE Corner NE 1/4-NE 1/4, Section 35-96-14: Set 5/8"Ø rebar w/2"Ø aluminum cap PLS 15525, equidistant and on line between the E 1/4 Corner and the NE Corner. PLAN - VIEW (Show a minimum of three reference ties to durable physical objects, relevant monuments and physical conditions that will enable recovery of the corner.) Sec. 35 T96N **R14W** Lower Deerfield Twp. Set Orange Cut-X Plastic Tag PLS 15525 Set Orange Hdwl Plastic Tag PLS 15525 RC-Box on the top Culvert of wood on the top bridge wing of wood 30.89 piling bridge wing piling 12,16 45.10 56.85 69.30 Set MAG Nall w/Stainless Steel Washer PLS 15525 on the 1/4-1/4 Section Une at the edge of the wood bridge deck Cor Cor C E 1/4 Corner Section 35-96-14 Set 5/8 Ø rebar w/2 Ø aluminum cap PLS 15525 SE Corner NE 1/4-NE 1/4 Corner Section 35-96-14 Set 5/8°Ø rebar w/2°Ø aluminum cap PLS 15525 I hereby certify that this land surveying document List Comers to be Indexed diameter. was prepared and the related survey work was Section TWD. Range Corners performed by me or under my direct personal 96 14 E 1/4 35 supervision and that I am a duly licensed Land Surveyor under the laws of the State of Iowa. SE-NE-NE 35 96 14 HEROLD - Soul R. Heroed Paul R. Herold Date: License number 15525 Project Number: 2007-121 My license renewal date is December 31, 2008. Sheets covered by this seal: Individual sheet only DO WOO FB: Chickasaw County 1, Pgs. 53-55