

Herold - Reicks Surveying, 10 East Main Street, New Hampton, IA 50659, Ph. 641-394-2725, Fax. 641-394-2718

UNITED STATES PUBLIC LAND SURVEY CORNER CERTIFICATE

Land Survey Monuments situated in Section 20, Township 97 North, Range 14 West of the Fifth Principal Meridian, Chickasaw County, Iowa. 1.) & 2.) Not previously recorded in the County Recorder's office.

This certificate is being prepared in compliance with Iowa Code Chapter 355.11 because:

- 1.) & 2.) There are no certificates on file for these corners.
 There are no longer three valid ties of record.
 There are changes to reference ties of record.
 There is change of monumentation of record.
 To clarify description of record monument (ties).


Monument Description and Remarks:

1.) **Northeast Corner:** Found 1/2"Ø rebar yellow plastic cap PLS 2886 with information obtained from a Survey and Plat made by L.P. Erdman, recorded in Bk. 145, Pg. 459 on file in the County Recorder's office.

2.) **East 1/4 Corner:** County Engineer's notes indicate "Cor. C, split ROW fences and set in line with fence to West Const. Point", We took measurements from the W 1/4 Corner of Section 20 across 4 fence positions heading East and took measurements from the E 1/4 of Section 21 across 3 fence positions heading West and lead us to the same position on the Centerline of Beaumont Ave. We accepted this position as the E 1/4 Corner of Section 20 and set a 5/8"Ø rebar with 2"Ø aluminum cap PLS 19211.

PLAN - VIEW

(Show a minimum of three reference ties to durable physical objects, relevant monuments and physical conditions that will enable recovery of the corner.)

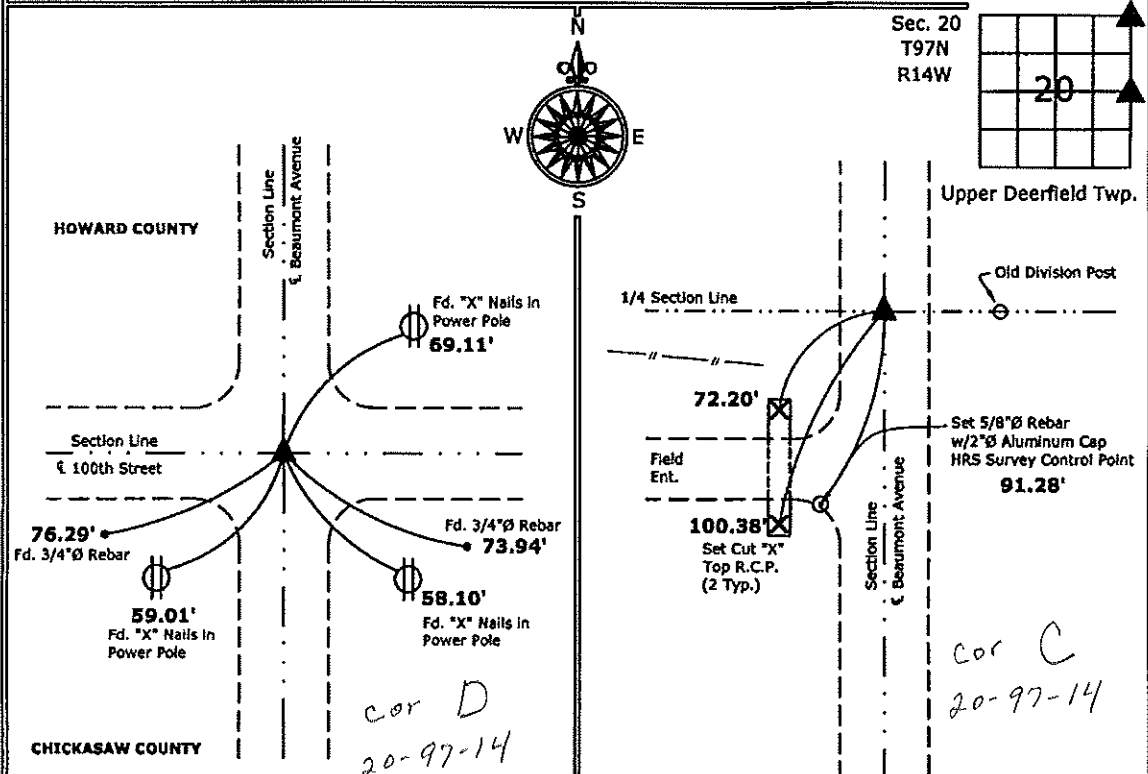

1.) **Northeast Corner Section 20-97-14**
 Found 1/2"Ø rebar w/ yellow plastic cap PLS 2886

2.) **East 1/4 Corner Section 20-97-14**
 Set 5/8"Ø rebar w/2"Ø aluminum cap PLS 19211



I hereby certify that this land surveying document was prepared and the related survey work was performed by me or under my direct personal supervision and that I am a duly licensed Land Surveyor under the laws of the State of Iowa.

Kirk D. Reicks 8-7-10
 Kirk D. Reicks Date:
 License number 19211
 My license renewal date is December 31, 2010.
 Sheets covered by this seal: Individual sheet only

List Corners to be Indexed			
Corners	Section	Twp.	Range
NE	20	97	14
E 1/4	20	97	14

Project Number: 2010-066

FB: Chickasaw County 1, Pgs. 43-45