

[illegible]

United States Public Land Survey Corner Certificate

Land Survey Monument situated in
Section **26**, Township **97** North, Range **14** West of the Fifth Principal Meridian, **Chickasaw** County, Iowa.
Not on file in the County Recorder's Office.

This certificate is being prepared in compliance with Iowa Code Chapter 355.11 because:

- ☒ There is no certificate on file for this corner.
☐ There are no longer three valid ties of record.
☐ There are changes to reference ties of record.
☐ There is change of monumentation of record.
☐ To clarify description of record monument (ties).


Monument Description and Remarks:

East 1/4 Corner:

Found 1"Ø Gas Pipe with information obtained from Chickasaw County Engineer's Office, in Field Book Deerfield North, Ties to Corners, Section 26, Corner C.

Plan View - Not to Scale

(Show a minimum of three reference ties to durable physical objects, relevant monuments and physical conditions that will enable recovery of the corner.)

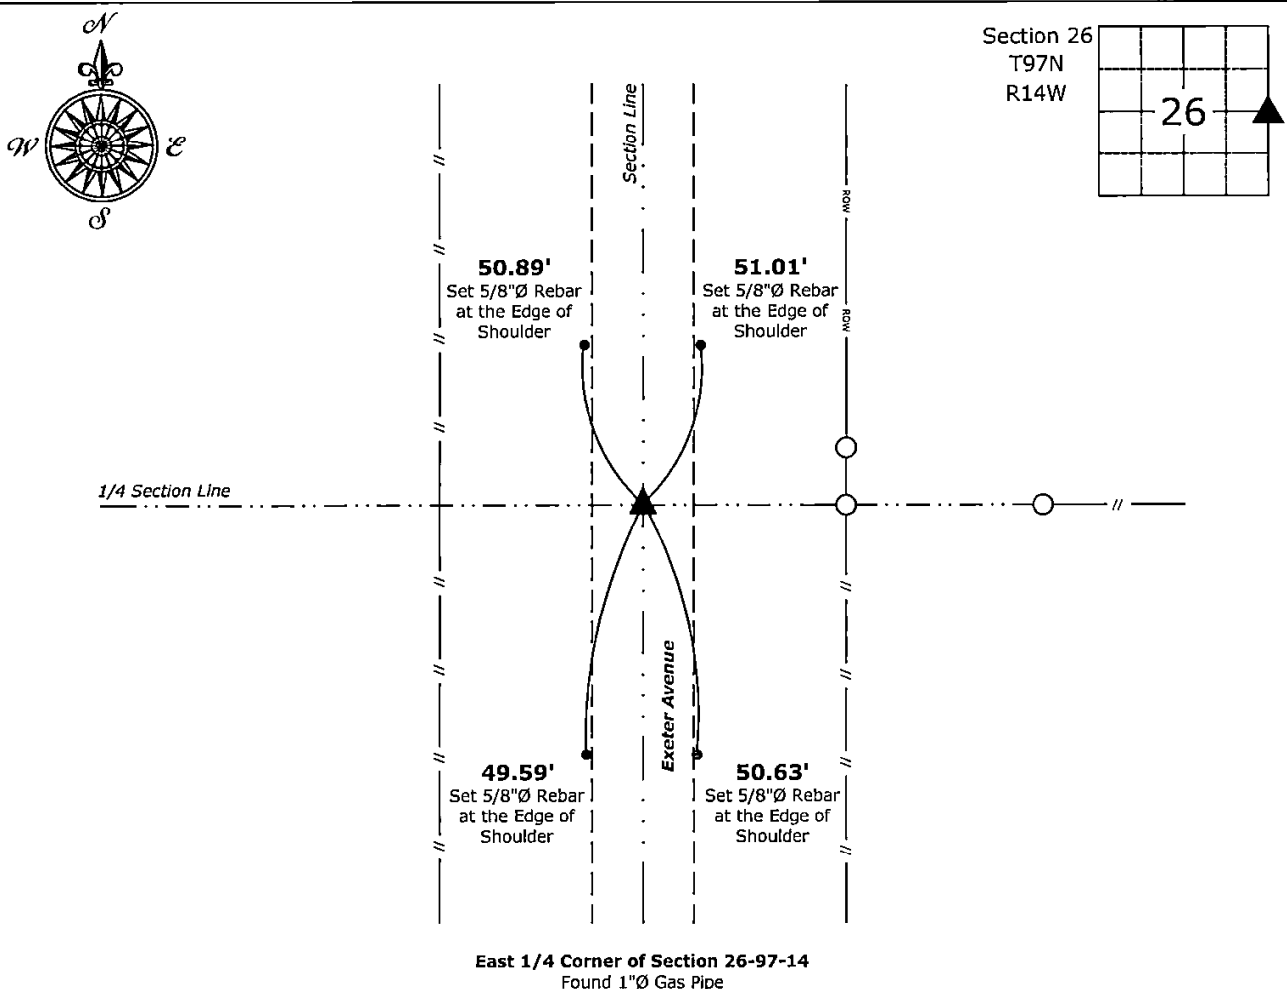

I hereby certify that this land surveying document was prepared and the related survey work was performed by me or under my direct personal supervision and that I am a duly licensed Land Surveyor under the laws of the State of Iowa.

Kirk D. Reicks 6-29-2026
Kirk D. Reicks Date:

License Number 19211

My License Renewal Date is December 31, 2026.

My License Renewal Date is December 31, 2020.
 Sheets covered by this seal: Individual sheet only

List Corner to be Indexed

Corner	Section	Township	Range
E 1/4	26	97	14

Project Number: 2026-066

FB: Chickasaw 14, Page(s) 55-56

File: S:__Projects - NHO\County Control Systems\CHICKASAW\CHICK-2\CHICK-2-2026.dwg, 6/29/2026 6:49:05 AM