

Prepared by & Return to: Herold - Reicks Surveying, 10 East Main Street, New Hampton, IA 50659, Ph. 641-394-2725

**UNITED STATES PUBLIC LAND SURVEY CORNER CERTIFICATE**

Land Survey Monuments situated in Section 27, Township 97 North, Range 14 West of the Fifth Principal Meridian, Chickasaw County, Iowa. 1.) Not previously recorded in the County Recorder's office. 2.) Previously recorded in Bk. 148, Pg. 250 in the County Recorder's office.

This certificate is being prepared in compliance with Iowa Code Chapter 355.11 because:

- 1.)  There is no certificate on file for this corner.
- 2.)  There are no longer three valid ties of record.
- 2.)  There are changes to reference ties of record.
- There is change of monumentation of record.
- To clarify description of record monument (ties).


Monument Description and Remarks:

- 1.) North 1/4 Corner: Found P.K. nail with information obtained from the County Engineer's office.
- 2.) South 1/4 Corner: Found 1/2"Ø rebar with information obtained from previous Section Corner Certificate.

**Note:** Both corners were shown on a Plat of Survey made by Lyle G. Tekippe recorded in Doc. #2004-1056

**PLAN - VIEW**

(Show a minimum of three reference ties to durable physical objects, relevant monuments and physical conditions that will enable recovery of the corner.)

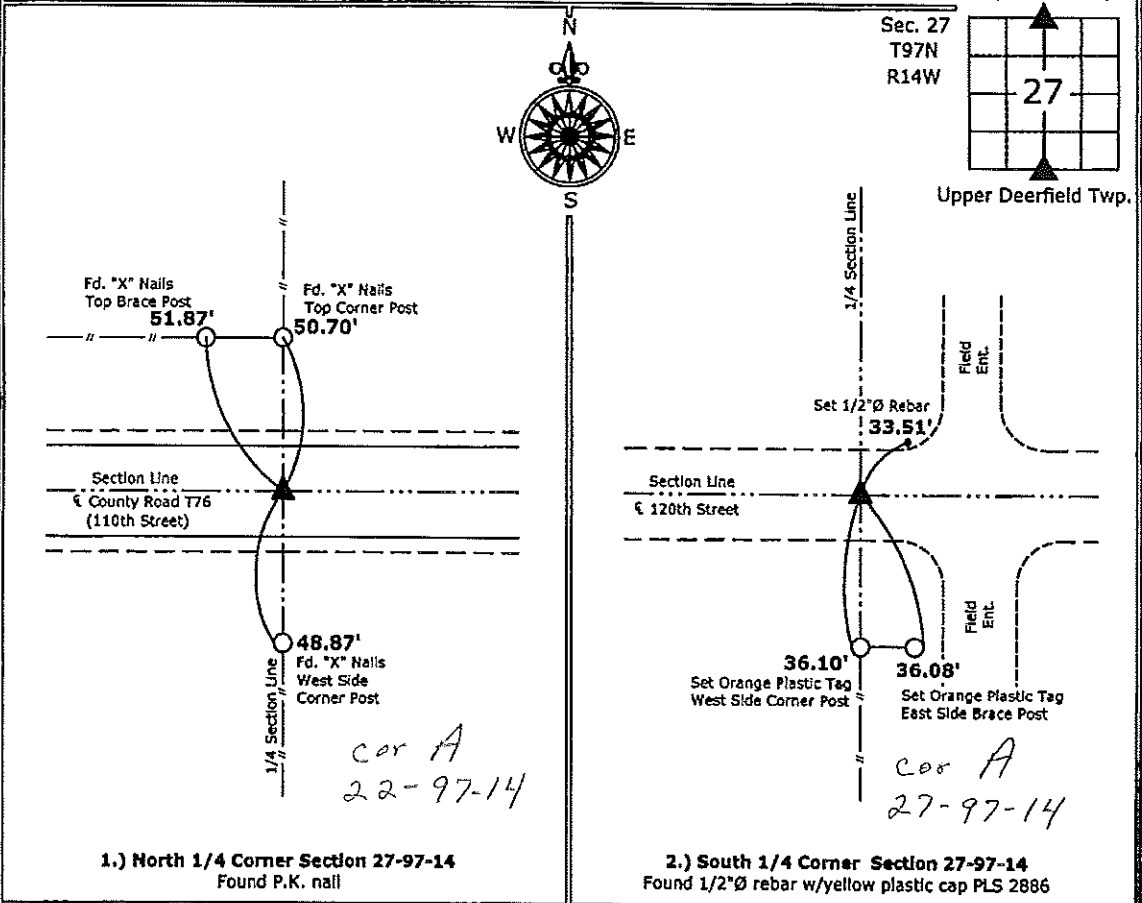

1.) North 1/4 Corner Section 27-97-14  
 Found P.K. nail

2.) South 1/4 Corner Section 27-97-14  
 Found 1/2"Ø rebar w/yellow plastic cap PLS 2886



I hereby certify that this land surveying document was prepared and the related survey work was performed by me or under my direct personal supervision and that I am a duly licensed Land Surveyor under the laws of the State of Iowa.  
*Paul R. Herold* 8-19-11  
 Paul R. Herold Date:  
 License number 15525  
 My license renewal date is December 31, 2012.  
 Sheets covered by this seal: Individual sheet only

List Corners to be Indexed			
Corners	Section	Twp.	Range
N 1/4	27	97	14
S 1/4	27	97	14

Project Number: 2011-072  
 FB: Chickasaw County 4, Pgs. 8-10