

UNITED STATES PUBLIC LAND SURVEY CORNER CERTIFICATE


SECTION 28 , TOWNSHIP 97 , RANGE 14 OF THE 5TH. P.M.
 IN CHICKASAW COUNTY, IOWA

CORNER: NW COR SE1/4, AKA CENTER
 DESCRIPTION AND REMARKS:

Found #5 REBAR

*Placed in
 Tie Book
 4/91
 JFM*

PREVIOUSLY RECORDED IN BOOK _____, PAGE _____

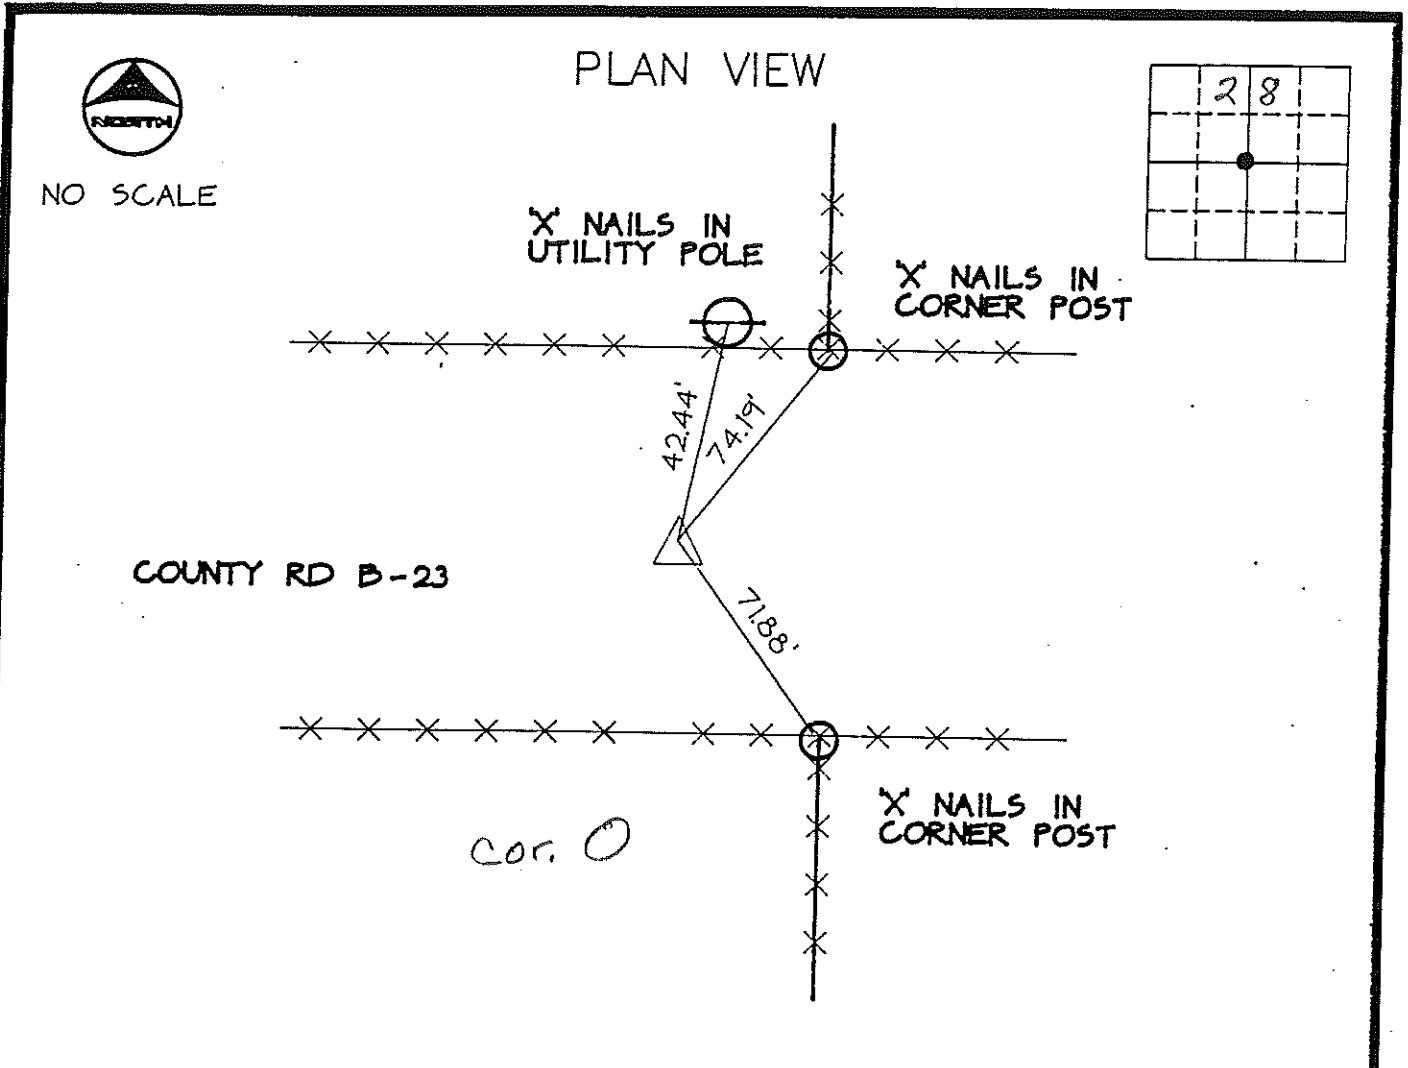

CERTIFICATION:
 I HEREBY CERTIFY THAT THIS MAP, PLAT, OR SURVEY WAS MADE BY
 ME OR UNDER MY DIRECT PERSONAL SUPERVISION AND THAT I AM A
 DULY REGISTERED LAND SURVEYOR UNDER THE LAWS OF THE STATE
 OF IOWA.

Thomas V. Craft
 THOMAS V. CRAFT REG. L.S. NO. 7549

DATE: 4/17/91



MCN/213850

INDEXING ALTERNATIVES

CORNER	SECTION	TWP	RANGE
--------	---------	-----	-------

47-120