

Herold - Reicks Surveying, 10 East Main Street, New Hampton, IA 50659, Ph. 641-394-2725, Fax. 641-394-2178

UNITED STATES PUBLIC LAND SURVEY CORNER CERTIFICATE

Land Survey Monuments situated in Section **20**, Township **97** North, Range **14** West of the Fifth Principal Meridian, **Chickasaw** County, Iowa. Both not previously recorded in the County Recorder's office.

This certificate is being prepared in compliance with Iowa Code Chapter 355.11 because:


1.) & 2.) There are no certificates on file for these corners.
 There are no longer three valid ties of record.
 There are changes to reference ties of record.
 There is change of monumentation of record.
 To clarify description of record monument (ties).

Monument Description and Remarks:

- 1.) West 1/4 Corner:** Set 5/8"Ø rebar with 2"Ø aluminum cap PLS 19211 with information obtained from the County Engineer's Office.
- 2.) SW Corner:** Set 5/8"Ø rebar with 2"Ø aluminum cap PLS 19211 with information obtained from the County Engineer's Office.

PLAN - VIEW

(Show a minimum of three reference ties to durable physical objects, relevant monuments and physical conditions that will enable recovery of the corner.)

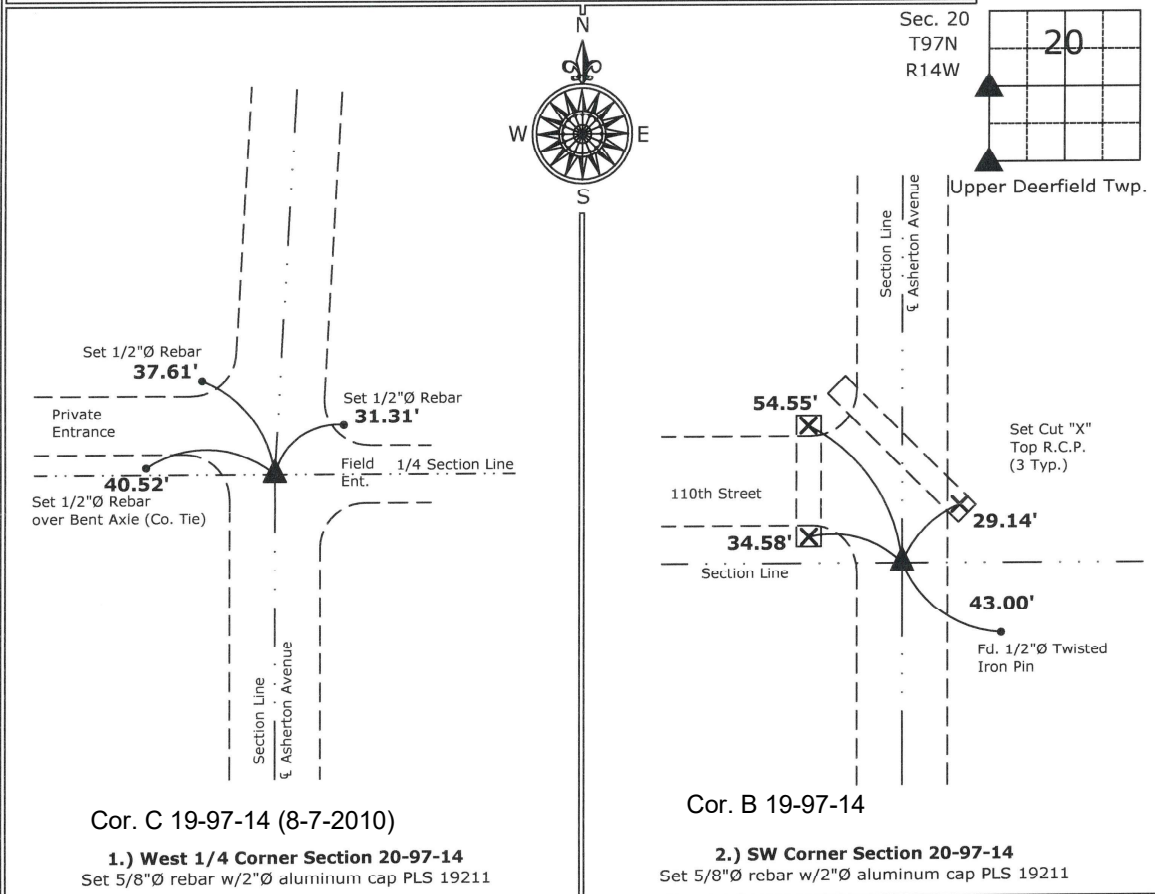

I hereby certify that this land surveying document was prepared and the related survey work was performed by me or under my direct personal supervision and that I am a duly licensed Land Surveyor under the laws of the State of Iowa.

Kirk D. Reicks 8-7-10
 Kirk D. Reicks Date:
 License number 19211
 My license renewal date is December 31, 2010.
 Sheets covered by this seal: Individual sheet only

List Corners to be Indexed			
Corners	Section	Twp.	Range
W 1/4	20	97	14
SW	20	97	14

Project Number: 2010-066
 FB: Chickasaw County 1, Pgs. 43-45

File: S:_Projects\2010-066\dwg\2010-066.dwg, 8/7/2010 10:12:06 AM