

STEVE BUSSE P.O. BOX 241 508 ELM ST. ALLISON, IOWA 50602 319-267-2519

UNITED STATES PUBLIC LAND SURVEY CORNER CERTIFICATE OF

LAND SURVEY MONUMENTS SITUATED IN SECTION NO. 30, TOWNSHIP NO. 97 NORTH, RANGE NO. 14 WEST OF THE FIFTH PRINCIPAL MERIDIAN, CHICKASAW COUNTY, IOWA.
 PREVIOUSLY RECORDED IN N/A


(SHOW REASON FOR PREPARING THIS CERTIFICATE, THE EVIDENCE AND DETAILED PROCEDURES USED IN ESTABLISHING THE CORNER POSITIONS AND MONUMENTATION FOUND OR PLACED.)


MONUMENT DESCRIPTION AND REMARKS:

Did not find certificate recorded for either corner. County ties call for iron pin at Center section. Searched area and obtained metal reading in center road and at split of row fences. Dug down and set 1/2" rebar with cap on top of iron pin. Found no record of monumentation at South 1/4 corner. Searched area on east-west fence at approximate corner. Found nothing. Extended fence line from north to the intersection with east-west fence line. Searched area for stone. Did not find anything down 4' from ground. Set 1/2" rebar with yellow plastic cap at fence line intersections. Used both corners in survey in section 30.

PLAN VIEW

(SHOW A MINIMUM OF THREE REFERENCE TIES TO DURABLE PHYSICAL OBJECTS, RELEVANT MONUMENTS AND PHYSICAL CONDITIONS THAT WILL ENABLE RECOVERY OF THE CORNER.)

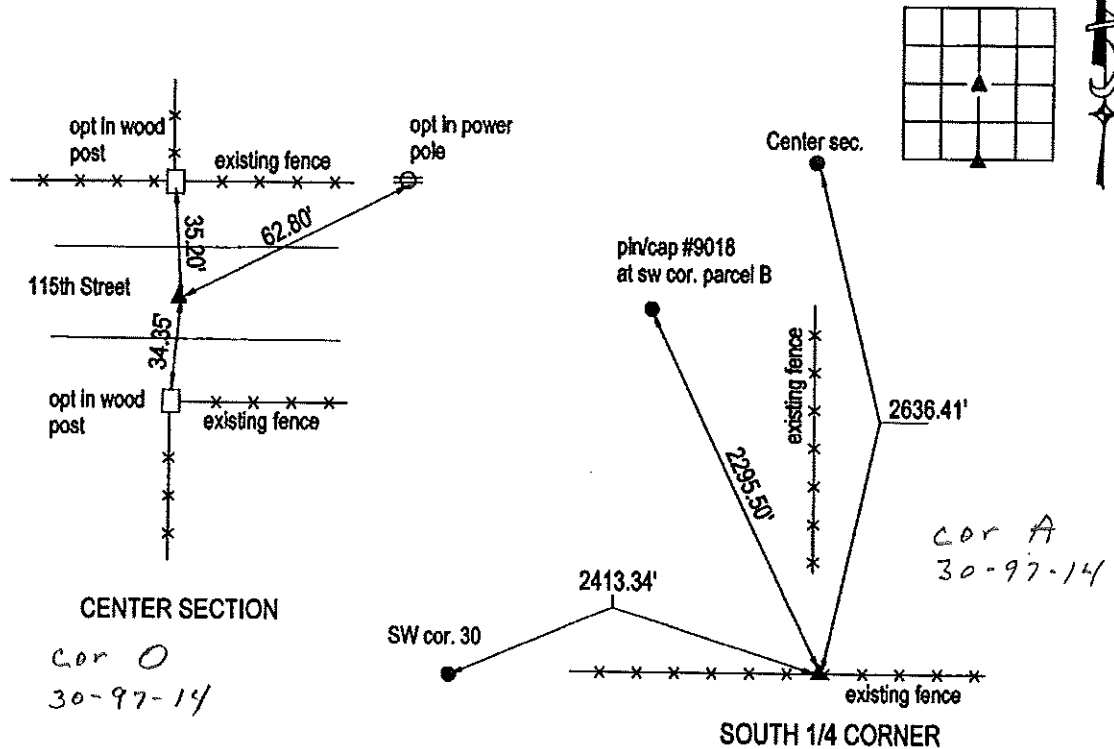

	I HEREBY CERTIFY THAT THIS LAND SURVEYING DOCUMENT WAS PREPARED AND THE RELATED SURVEY WORK WAS PERFORMED BY ME OR UNDER MY DIRECT PERSONAL SUPERVISION AND THAT I AM A DULY LICENSED LAND SURVEYOR UNDER THE LAWS OF THE STATE OF IOWA.	G.P. = 2" GAS PIPE CONC MONU = CONCRETE MONUMENT W/ PIN & ALUM CAP "X NAILS" = CROSS NAILS IN WOOD POST OPT = PLASTIC TAG (O=ORANGE, Y=YELLOW) (00) RECORDED AS															
	LICENSE NUMBER 9018 MY LICENSE RENEWAL DATE IS DECEMBER 31, 2012 PAGES OR SHEETS COVERED BY THIS SEAL <u>1</u>	<table border="1" style="width: 100%; border-collapse: collapse;"> <thead> <tr> <th colspan="4" style="text-align: center;">LIST CORNERS TO BE INDEXED</th> </tr> <tr> <th style="text-align: left;">CORNER</th> <th style="text-align: left;">SECTION</th> <th style="text-align: left;">TOWNSHIP</th> <th style="text-align: left;">RANGE</th> </tr> </thead> <tbody> <tr> <td>CENTER SECTION</td> <td>30</td> <td>97</td> <td>14</td> </tr> <tr> <td>SOUTH 1/4 COR.</td> <td>30</td> <td>97</td> <td>14</td> </tr> </tbody> </table>	LIST CORNERS TO BE INDEXED				CORNER	SECTION	TOWNSHIP	RANGE	CENTER SECTION	30	97	14	SOUTH 1/4 COR.	30	97
LIST CORNERS TO BE INDEXED																	
CORNER	SECTION	TOWNSHIP	RANGE														
CENTER SECTION	30	97	14														
SOUTH 1/4 COR.	30	97	14														