

Chickasaw Co. Recorder
Cindy Messersmith
Fee Book 2017-0035

01/06/2017 @0936AM
SCC SEC COR CERT # Pages: 1
Book: Page: Total Fees: \$7.00

MOHN SURVEYING INC. ROGER R. MOHN 1890 GREAT RIVER ROAD LANSING, IOWA 52151 (563) 538-4067

TIES, DWG Bruening Rock Products

SLSI 9-90

UNITED STATES PUBLIC LAND SURVEY CORNER CERTIFICATE

OF

Land Survey Monuments situated in Section 33, Township 97 North, Range 14 West, of the Fifth Principal Meridian, Chickasaw County, Iowa.
Previously recorded in 2004-1308 in County Recorder's Office.


(book, page, document number, etc.)

(Show reason for preparing this certificate, the evidence and detailed procedures used in establishing the corner positions and monumentation found or placed.)

Monument Description and Remarks: Found PK nail 4" below ACC pavt. as per Corner Certificate that is recorded as Doc. #2004-1308. Set mag nail with washer no. 10165 above said PK nail at ACC surface. One accessory missing. Replaced missing accessory.

PLAN - VIEW

(Show a minimum of three reference ties to durable physical objects, relevant monuments and physical conditions that will enable recovery of the corner.)

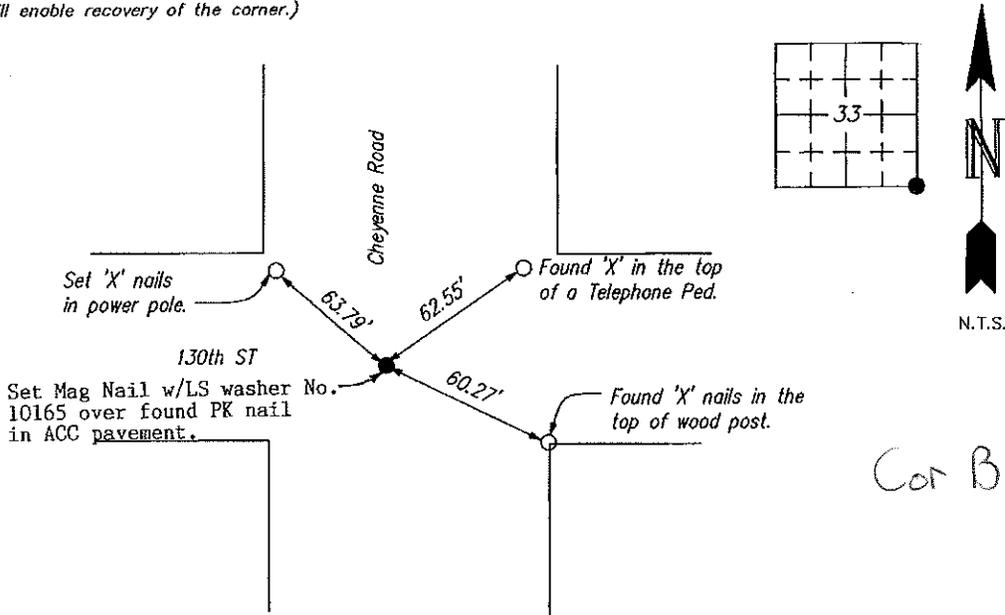

I hereby certify that this land surveying document was prepared by me or under my direct personal supervision and that I am a duly Registered Land Surveyor under the laws of the state of Iowa.

Roger R. Mohn 1/05, 2017
ROGER R. MOHN, P.E. & L.S. Iowa Registration No. 10165
My registration expires December 31, 2018

Corners	List Corners to be Indexed		
	Section	Twp	Range
SE Cor.	33	97N	14W

SEAL

