

Prepared by & Return to: Herold - Reicks Surveying, 10 East Main Street, New Hampton, IA 50659, Ph. 641-394-2725

**UNITED STATES PUBLIC LAND SURVEY CORNER CERTIFICATE**

Land Survey Monuments situated in Section 10, Township 94 North, Range 12 West of the Fifth Principal Meridian, Chickasaw County, Iowa. 1.) Previously recorded in Document #2002-2749 in the County Recorder's office. 2.) Not previously recorded in the County Recorder's office.

This certificate is being prepared in compliance with Iowa Code Chapter 355.11 because:


- There is no certificate on file for this corner.
- There are no longer three valid ties of record.
- There are changes to reference ties of record.
- There is change of monumentation of record.
- To clarify description of record monument (ties).

**Monument Description and Remarks:**

- 1.) **Northwest Corner:** Fd. 3/4"Ø rebar from information obtained from previous Section Corner Certificate. Previous Section Corner Certificate had error in reference monument designations, prepared new Certificate to correct errors.
- 2.) **East 1/4 Corner:** Fd. 5/8"Ø iron pin with information obtained from the County Engineer's office in Field Book Dresden Township, Section 10, Corner "C".


**PLAN - VIEW**

(Show a minimum of three reference ties to durable physical objects, relevant monuments and physical conditions that will enable recovery of the corner.)

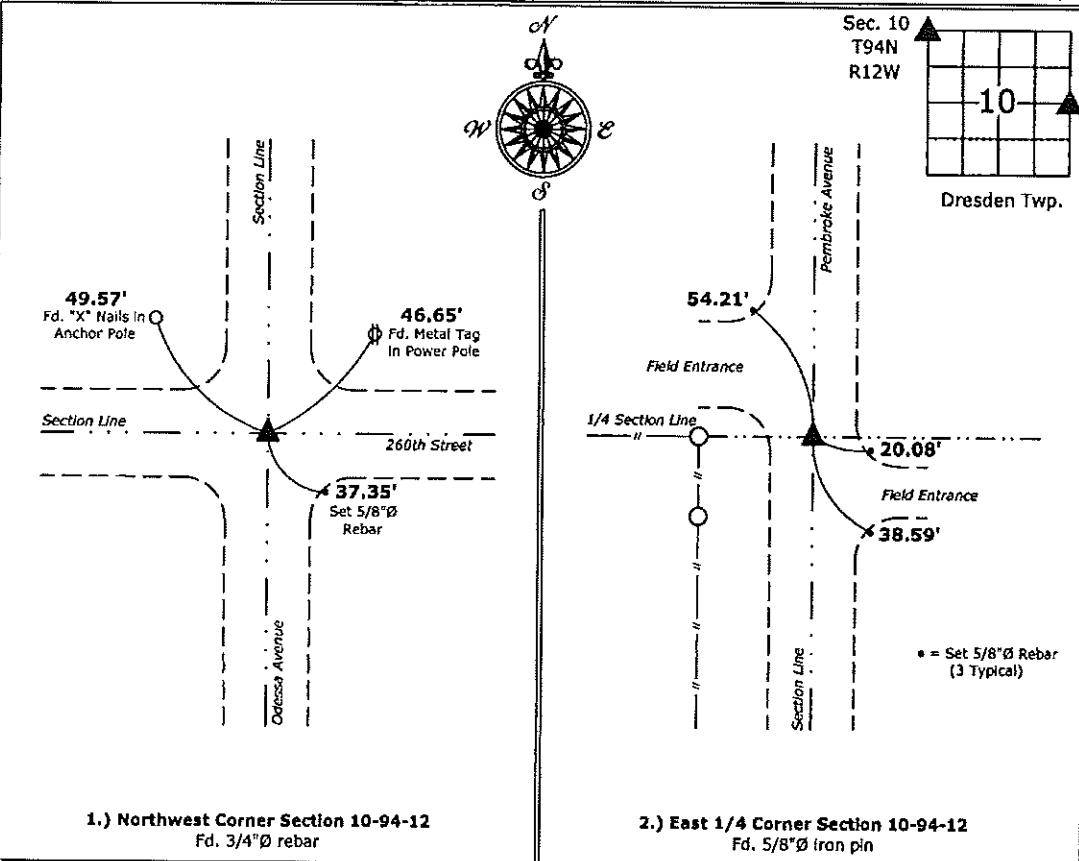

1.) Northwest Corner Section 10-94-12  
 Fd. 3/4"Ø rebar

2.) East 1/4 Corner Section 10-94-12  
 Fd. 5/8"Ø iron pin

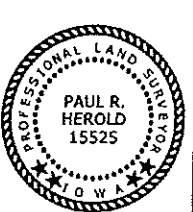

I hereby certify that this land surveying document was prepared and the related survey work was performed by me or under my direct personal supervision and that I am a duly licensed Land Surveyor under the laws of the State of Iowa.  
*Paul R. Herold* 12-22-14  
 Paul R. Herold Date:  
 License number 15525  
 My license renewal date is December 31, 2014.  
 Sheets covered by this seal: Individual sheet only

List Corners to be Indexed			
Corners	Section	Twp.	Range
NW	10	94	12
E 1/4	10	94	12

Project Number: 2014-252  
 FB: Chickasaw County 6, Pgs. 65-66