



Prepared by & Return to: Kirk D. Reicks, HRS, LLC, 10 East Main Street, New Hampton, IA 50659, Phone 641-394-2725

United States Public Land Survey Corner Certificate

Land Survey Monument situated in
 Section 15, Township 94 North, Range 12 West of the Fifth Principal Meridian, Chickasaw County, Iowa.
 Not on file in the County Recorder's Office.

This certificate is being prepared in compliance with Iowa Code Chapter 355.11 because:


- There is no certificate on file for this corner.
- There are no longer three valid ties of record.
- There are changes to reference ties of record.
- There is change of monumentation of record.
- To clarify description of record monument (ties).

Monument Description and Remarks:


Northeast Corner of the NW 1/4 - SE 1/4:
 Set 5/8"Ø Rebar w/2"Ø Aluminum Cap PLS 19211 on line between the Center and East 1/4 Corners, both of said Section and on the Northerly Extension of a Line from the Southeast Corner of the NW 1/4 - SE 1/4 through an old wood division post with information obtained from Surveyor's Record Book, Page 78 on file in the County Engineer's Office. Searched for any type of Monument around the old post, but did not locate anything.

Plan View - Not to Scale

(Show a minimum of three reference ties to durable physical objects, relevant monuments and physical conditions that will enable recovery of the corner.)

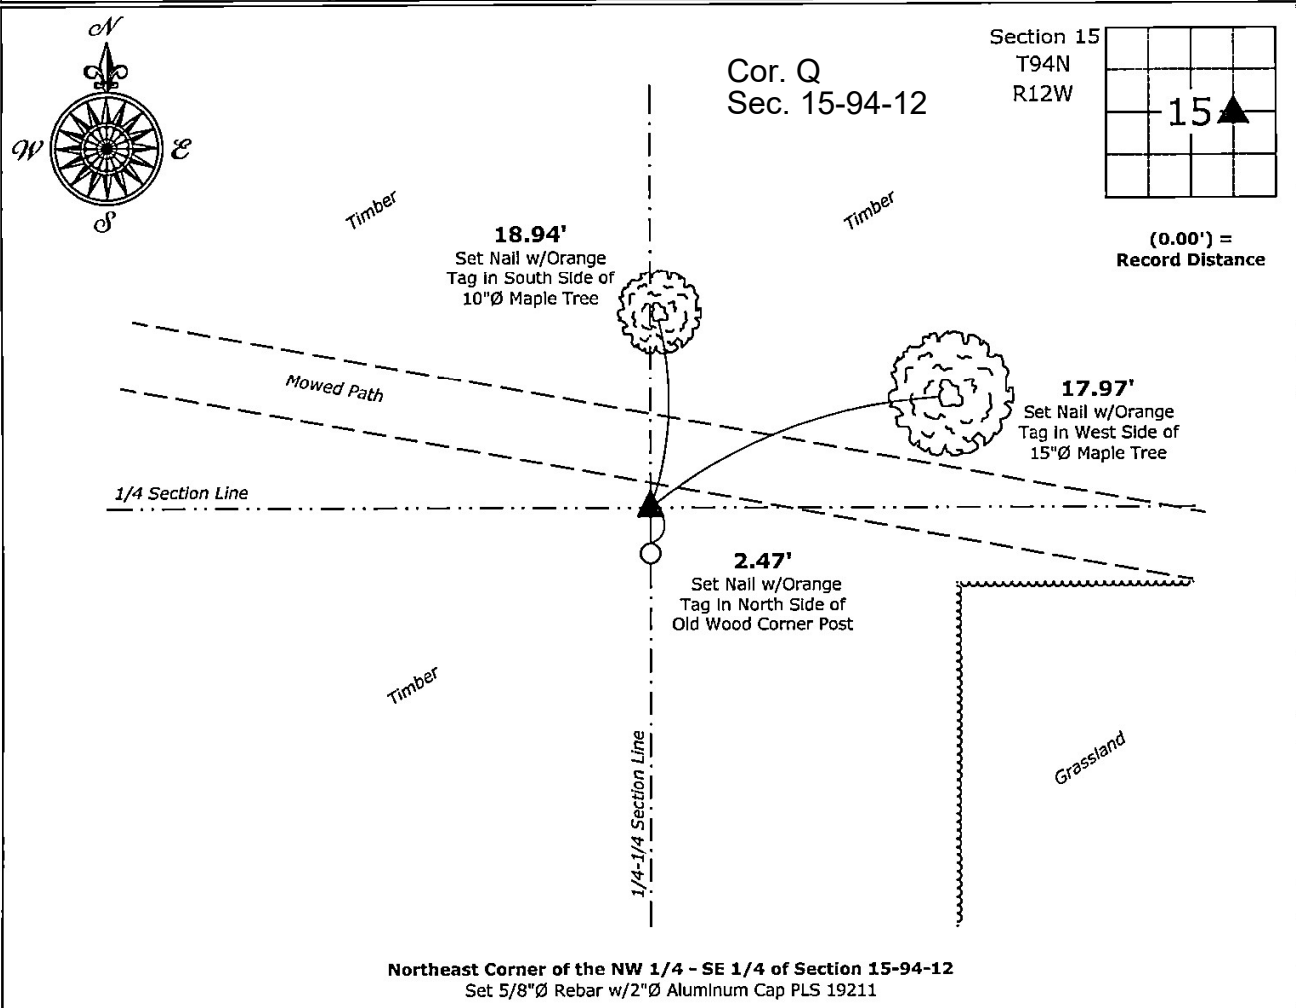

Northeast Corner of the NW 1/4 - SE 1/4 of Section 15-94-12
 Set 5/8"Ø Rebar w/2"Ø Aluminum Cap PLS 19211

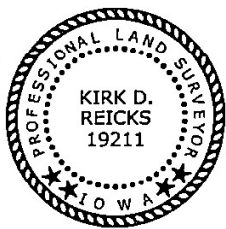

I hereby certify that this land surveying document was prepared and the related survey work was performed by me or under my direct personal supervision and that I am a duly licensed Land Surveyor under the laws of the State of Iowa.

Kirk D. Reicks 1-15-2024
 Kirk D. Reicks Date:

License number 19211
 My license renewal date is December 31, 2024.
 Sheets covered by this seal: Individual sheet only

List Corner to be Indexed			
Corner	Section	Township	Range
NE-NW-SE	15	94	12
Project Number: 2023-156			
FB: Chickasaw 12, Page(s) 44-46			

File: S:\Projects - NHO\County Control Systems - NHO\CHICKASAW\CHICK-43 (F-Burg)\CHICK-43 - 2022.dwg, 1/15/2024 4:28:57 PM