

Instrument #: 2017-2106
 12/13/2017 02:48:43 PM Total Pages: 1
 SCC SECTION CORNER CERTIFICATES
 Recording Fee: \$ 7.00
 Cindy Messersmith, Recorder, Chickasaw County Iowa

Prepared by & Return to: Herold - Reicks Surveying, 10 East Main Street, New Hampton, IA 50659, Ph. 641-394-2725

United States Public Land Survey Corner Certificate

Land Survey Monument situated in
 Section 19, Township 94 North, Range 12 West of the Fifth Principal Meridian, Chickasaw County, Iowa.
 Not on file in the County Recorder's office.

This certificate is being prepared in compliance with Iowa Code Chapter 355.11 because:


- There is no certificate on file for this corner.
- There are no longer three valid ties of record.
- There are changes to reference ties of record.
- There is change of monumentation of record.
- To clarify description of record monument (ties).

Monument Description and Remarks:

N 1/4 Corner: Fd. 3"Ø Alum. Monument I.D.O.T. with information in a Warranty Deed for acquisition of Right-of-Way for the Iowa Department of Transportation, Recorded January 14, 2000, Document #2000-0105, on file in the Chickasaw County recorder's Office, New Hampton, Iowa.

Plan View

(Show a minimum of three reference ties to durable physical objects, relevant monuments and physical conditions that will enable recovery of the corner.)

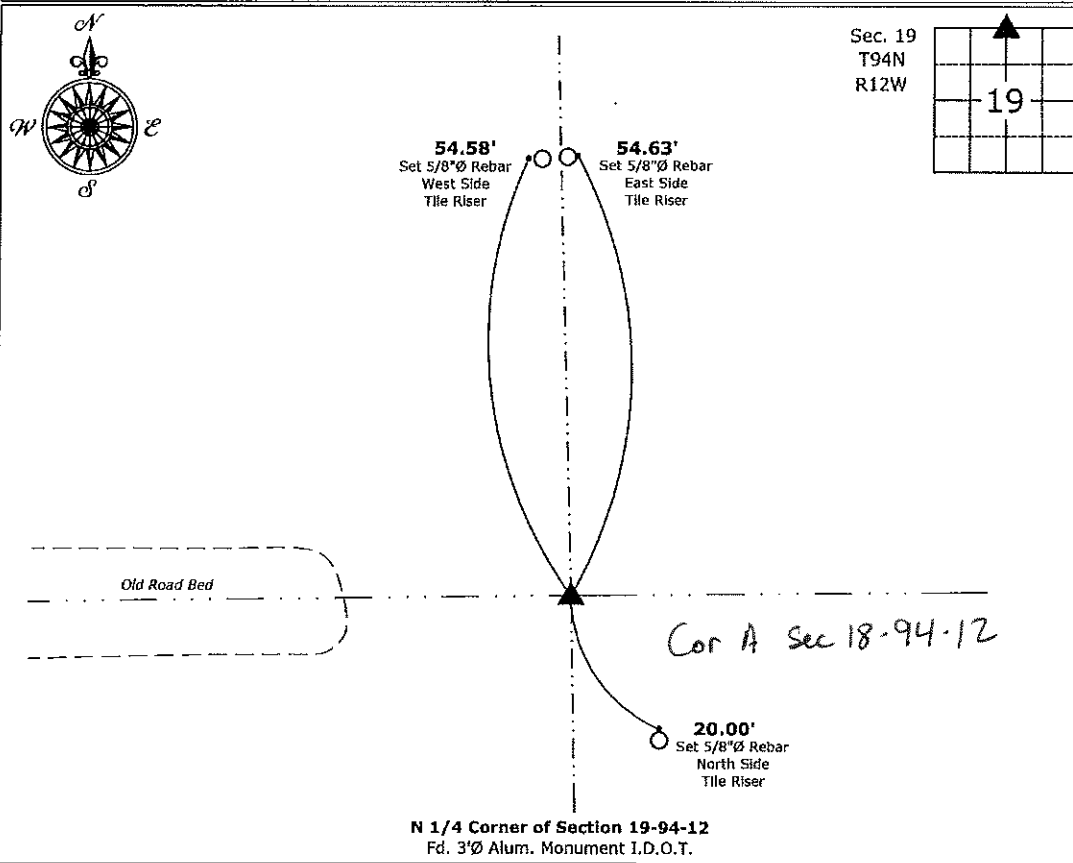

N 1/4 Corner of Section 19-94-12
 Fd. 3"Ø Alum. Monument I.D.O.T.



I hereby certify that this land surveying document was prepared and the related survey work was performed by me or under my direct personal supervision and that I am a duly licensed Land Surveyor under the laws of the State of Iowa.

Paul R. Herold 12-13-17
 Paul R. Herold Date:
 License number 15525
 My license renewal date is December 31, 2018.
 Sheets covered by this seal: Individual sheet only

List Corner to be Indexed			
Corner	Section	Twp.	Range
N 1/4	19	94	12
Project Number: 2017-100			
FB: Chickasaw County 8, Pgs. 49-50			

File: S:_C3D Projects\County Control Systems\CHICKASAW\CHICK-49.dwg, 12/13/2017 10:11:16 AM