

FILED 2002-0695
 RECORDER'S OFFICE
 CHICKASAW COUNTY, IOWA

2002 MAR 15 AM 8 55

CINDY MESSERSMITH
 COUNTY RECORDER

TEKIPPE ENGINEERING, P.C., 126 South Vine Street, West Union, Iowa 52175 Phone (563) 422-5131

UNITED STATES PUBLIC LAND SURVEY CORNER CERTIFICATE

OF

Land Survey Monuments situated in Section 17, Township 94 North, Range 12 West of the Fifth Principal Meridian, CHICKASAW County, Iowa.

Previously recorded in none in County Recorder's Office.
(book, page, document number, etc.)

(Show reason for preparing this certificate, the evidence and detailed procedures used in establishing the corner positions and monumentation found or placed.)


Monument Description and Remarks: SW Corner Section 17 T94N R12W: Found 3"Ø Iowa DOT aluminum monument, with information obtained from the Chickasaw County Engineer's Office in Field Book Dresden Twp. Corner Ties as Corner 'B', Section 18.

SE Corner Section 17 T94N R12W: Found 1/2"Ø rebar with information obtained from a Survey and Plat made by Thomas Craft recorded in the Chickasaw County Recorder's Office in Deeds Book 133, Page 359 on December 3, 1984.

PLAN - VIEW


Project Number 02028.LS
 FB. 461 PG. 61-68

(Show a minimum of three reference ties to durable physical objects, relevant monuments and physical conditions that will enable recovery of the corner.)

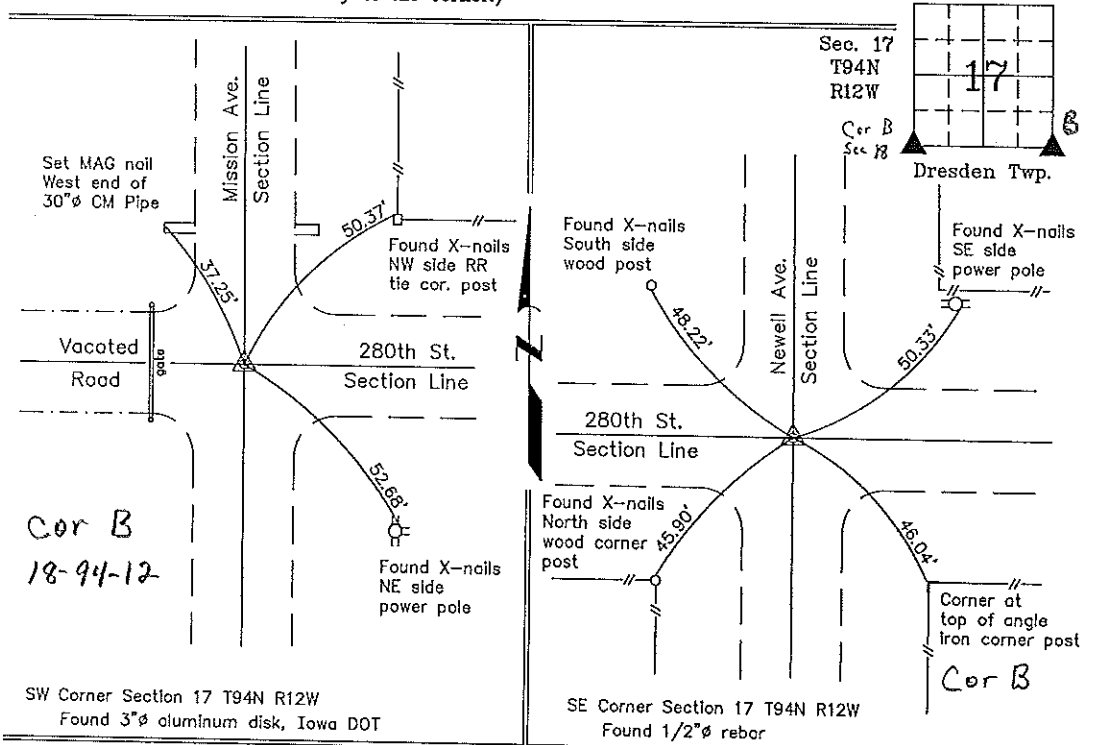

SW Corner Section 17 T94N R12W
 Found 3"Ø aluminum disk, Iowa DOT

SE Corner Section 17 T94N R12W
 Found 1/2"Ø rebar

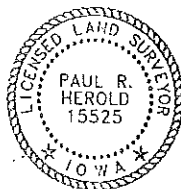

I hereby certify that this land surveying document was prepared and the related survey work was performed by me or under my direct personal supervision and that I am a duly licensed Land Surveyor under the laws of the State of Iowa.

Paul R. Herold 3-13-02
 Paul R. Herold Date
 License number 15525
 My license renewal date is December 31, 2002.
 Sheets covered by this seal: Individual

List Corners to be Indexed			
Corners	Section	Twp.	Range
SW	17	94N	12W
SE	17	94N	12W

Filed 3-28-02

Counters...