

Chickasaw Co. Recorder
 Cindy Messersmith
Fee Book 2010-1926
 11/24/2010 @1024AM
 SCC SEC COR CERT Page: 1
 Total Fees: \$9.00 # Pages: 1

Jeffrey P. Helland, 1107 Technology Parkway, Cedar Falls, Iowa 50613-6951, (319)-266-0161

UNITED STATES PUBLIC LAND SURVEY CORNER CERTIFICATE OF

LAND SURVEY MONUMENTS SITUATED IN SECTION NO. 20, TOWNSHIP NO. 94 NORTH, RANGE
 NO. 12 WEST OF THE FIFTH PRINCIPAL MERIDIAN, CHICKASAW COUNTY, IOWA.
 PREVIOUSLY RECORDED IN N/A

(SHOW REASON FOR PREPARING THIS CERTIFICATE, THE EVIDENCE AND DETAILED PROCEDURES USED IN ESTABLISHING THE CORNER POSITIONS AND MONUMENTATION FOUND OR PLACED.)


MONUMENT DESCRIPTION AND REMARKS:

NO USPLSCC ON FILE. SURVEY COMPLETED IN THE NW 1/4 OF SEC. 20-T94N-R12W.

→ E 1/4 CORNER: CHICKASAW COUNTY ENGINEER'S REFERENCE TIES DATED 4/20/1964 CALLS FOR [SPLIT FENCES & SET IRON PIN FOR CONST. ONLY 4-20-64. IRON PIN IS ABOUT 4 FT WEST OF CENTER LINE OF ROAD.]. FOUND NO. 4 REBAR (0.2' DEEP) CORRESPONDING WITH SAID REFERENCE TIES. NO OTHER EVIDENCE OF CORNER AVAILABLE, ACCEPTED SAID NO. 4 REBAR AS BEST EVIDENCE OF CORNER.

PLAN VIEW

(SHOW A MINIMUM OF THREE REFERENCE TIES TO DURABLE PHYSICAL OBJECTS, RELEVANT MONUMENTS AND PHYSICAL CONDITIONS THAT WILL ENABLE RECOVERY OF THE CORNER.)

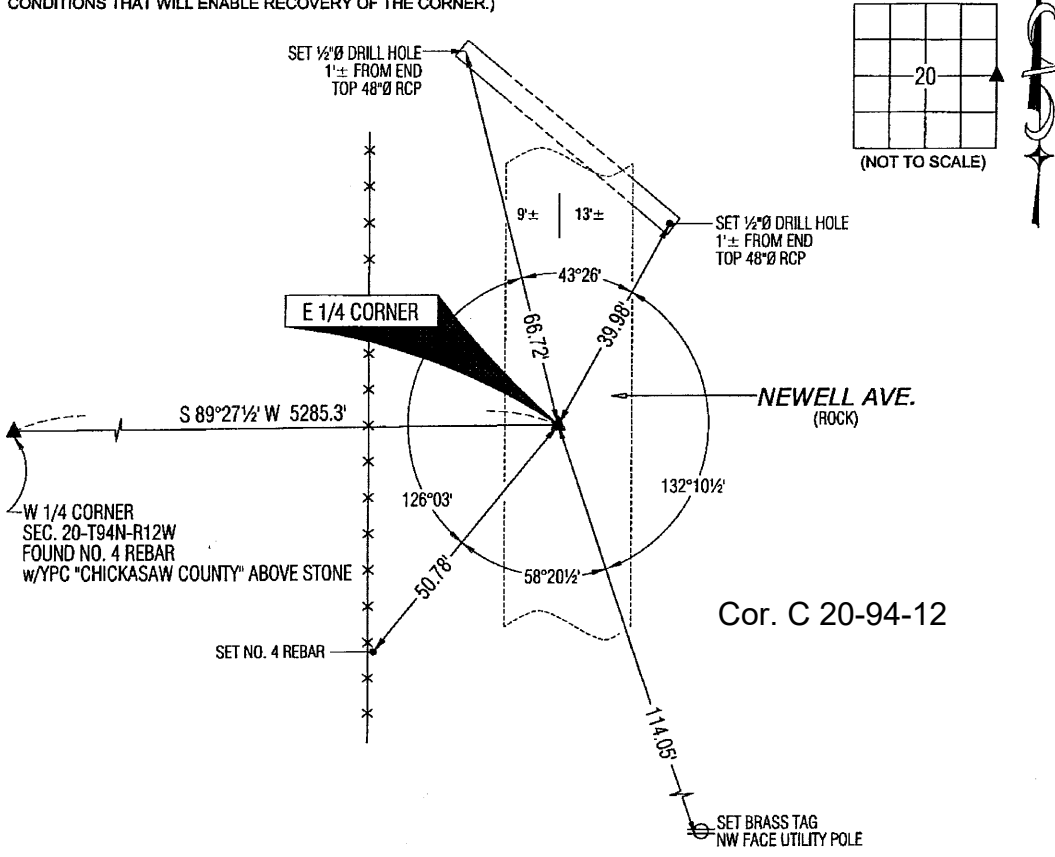


(BEARINGS ARE ASSUMED)



HELLAND ENGINEERING & SURVEYING, LTD.
 1107 Technology Parkway
 Cedar Falls, Iowa 50613-6951
 (319)-266-0161

SHINER = 8D NAIL & 1 5/16" METAL SHINER
 BRASS TAG = 8D NAIL & 13/16" BRASS TAG
 OPC = PLASTIC CAP (O=ORANGE, R=RED, Y=YELLOW)
 (00') RECORDED AS FILE NAME: 10-246C1.DWG

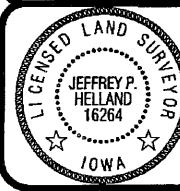

I hereby certify that this land surveying document was prepared and the related survey work was performed by me or under my direct personal supervision and that I am a duly licensed Land Surveyor under the laws of the State of Iowa.
Jeffrey P. Helland 10/29/10
 Jeffrey P. Helland
 License Number 16264
 My license renewal date is December 31, 2011.
 All pages or sheets are covered by this seal except:

LIST CORNERS TO BE INDEXED			
CORNER	SECTION	TOWNSHIP	RANGE
E 1/4 CORNER	20	94N	12W
W 1/4 CORNER	21	94N	12W

Rec.