

Section 15-94-12  
 As referred to in  
 Engr. Tie Book

UNITED STATES PUBLIC LAND SURVEY CORNER CERTIFICATE


OF  
 Land Survey Monuments situated in Section 22<sup>15</sup>, Township 94 North, Range  
12 West, of the Fifth Principal Meridian, CHICKASAW County, Iowa.  
 Previously recorded in NONE in County Recorder's Office.  
(book, page, document number, etc.)

(Show reason for preparing this certificate, the evidence and detailed procedures used in establishing the corner positions and monumentation found or placed.)

Monument Description and Remarks: NE CORNER, SECTION 22-T94N-R12W:  
Found T-Bar with cap.  
NW CORNER, SE 1/4-NE 1/4, SECTION 22-T94N-R12W: Set 1/2" Rebar  
with cap @ Existing Angle Iron Fence corner. Checked Corner  
relative to N 1/4 Corner, NE Corner, E 1/4 Corner & Post @ Center  
of Section.

PLAN - VIEW

(Show a minimum of three reference ties to durable physical objects, relevant monuments and physical conditions that will enable recovery of the corner.)

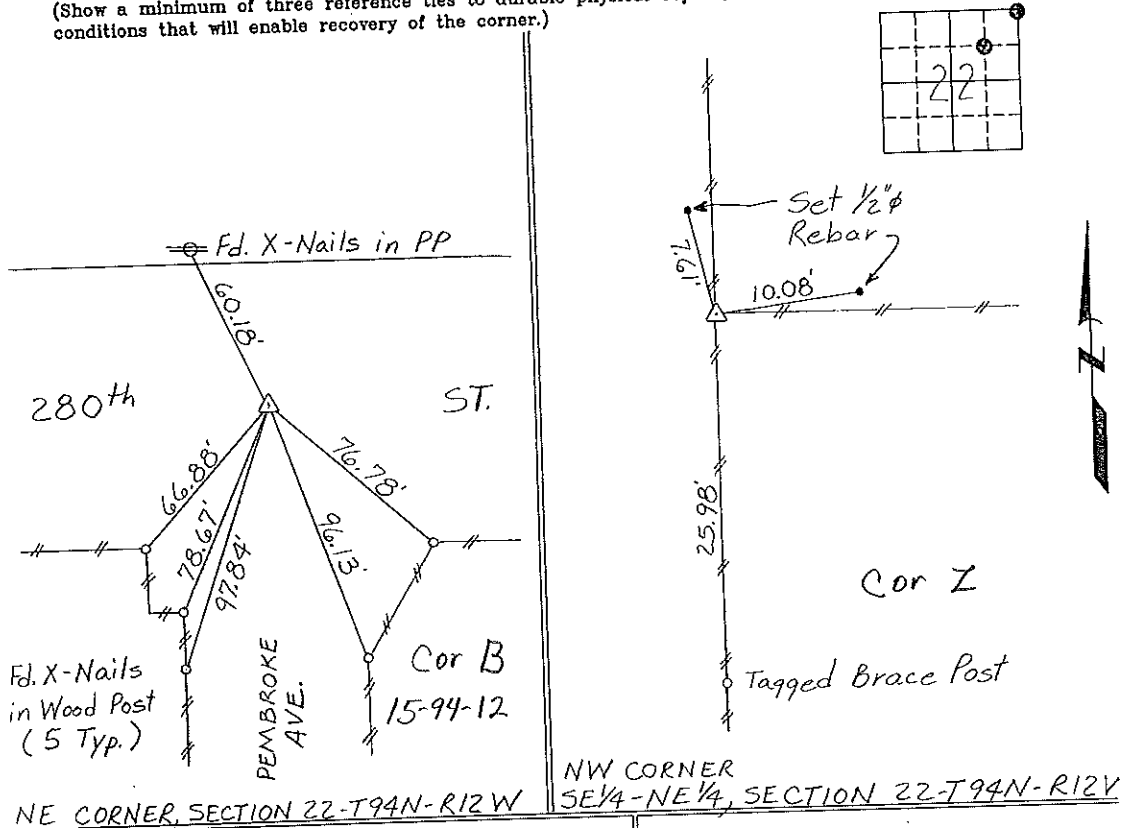

I hereby certify that the survey work was completed and this certificate was prepared by me or under my direct personal supervision and that I am a duly registered land surveyor under the laws of the state of Iowa.

Signature: Gary L. Casady  
 Gary L. Casady  
 Date: 2-8-95 Reg. No. 12532  
 My Registration Renewal Date is December 31, 1996

Seal




List Corners to be Indexed			
Corners	Section	Twp.	Range
NE Cor B	22	94N	12W
	15-94-12		
NW CORNER			
SE 1/4-NE 1/4	22	94N	12W
Cor X	22-94-12		

Placed on Tie Bar  
 3/1/95

Take to Chickasaw Co. Eng's. office

Cor B Sec 15 Cor A Sec 14

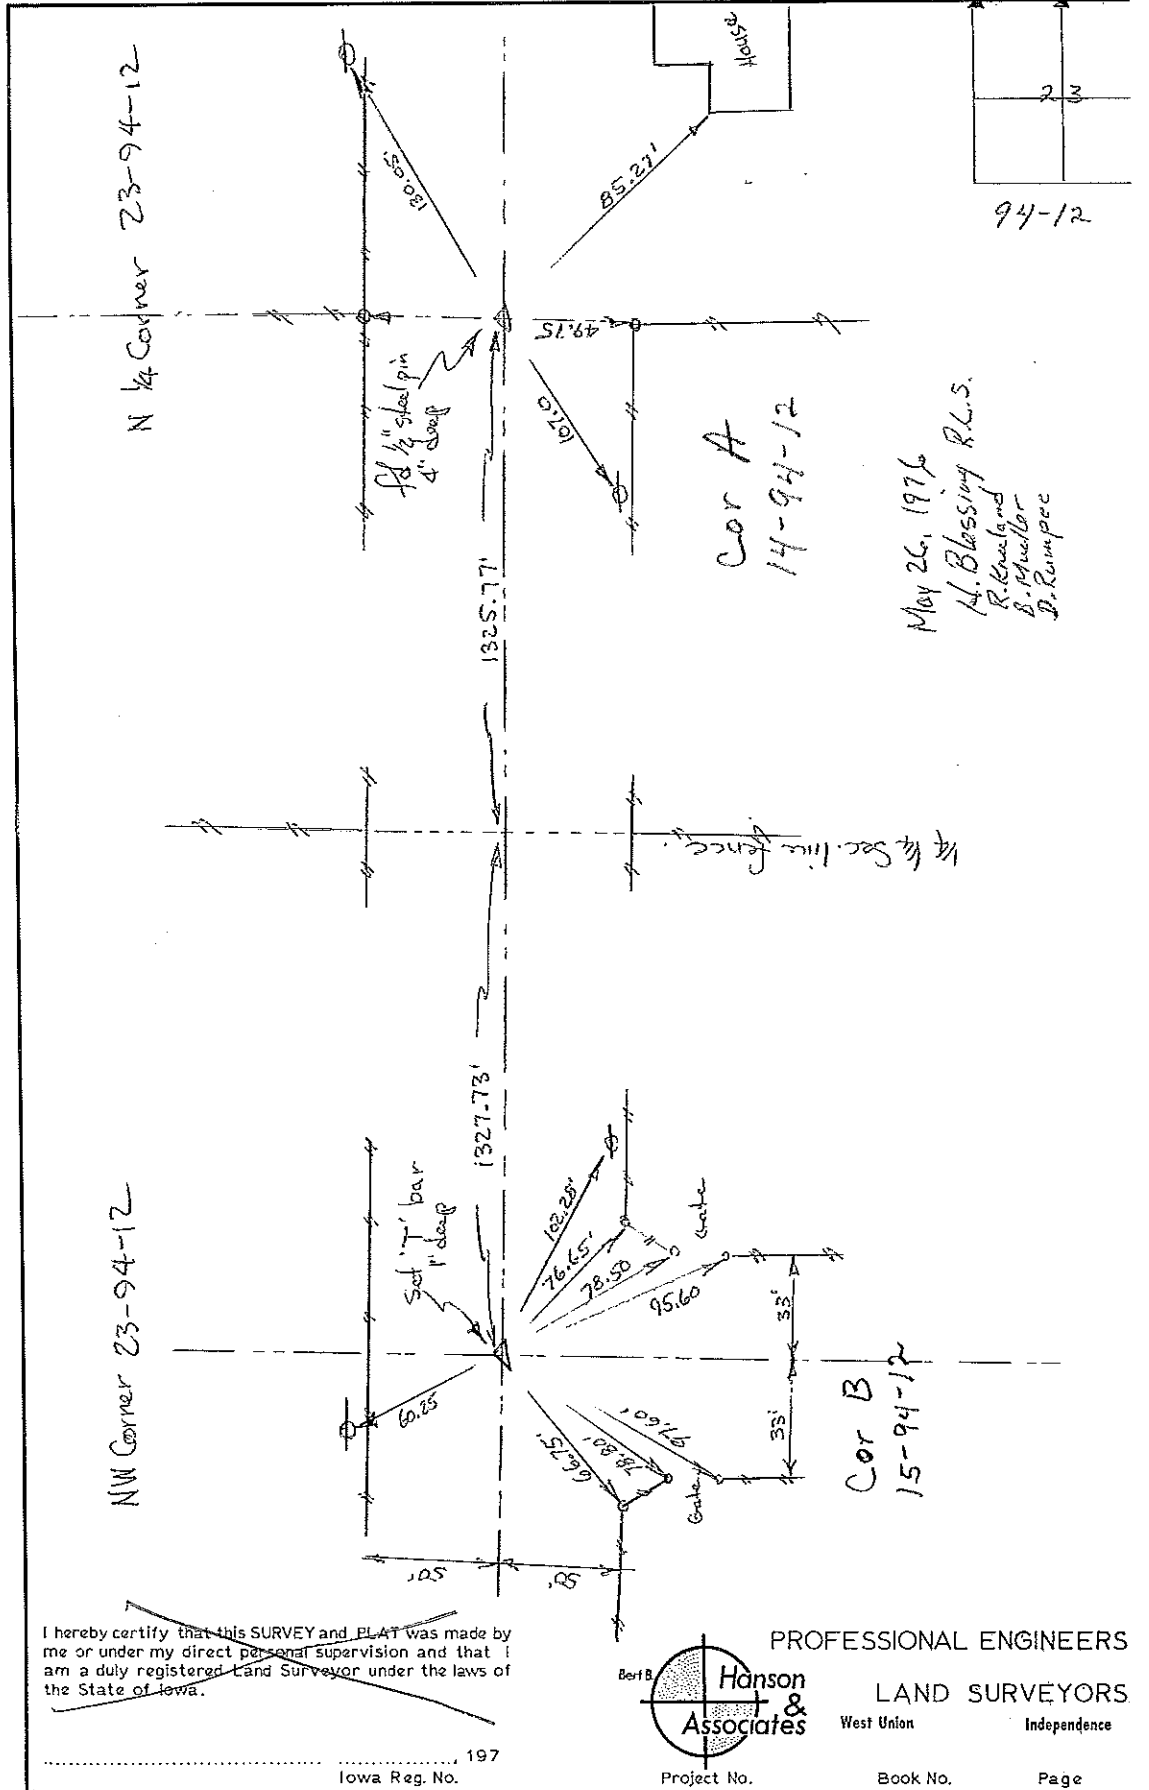

N 1/4 Corner 23-94-12


NW Corner 23-94-12

Cor A  
14-94-12

Cor B  
15-94-12

May 26, 1976  
H. Blossing R.L.S.  
R. Knealand  
B. Mueller  
D. Rampecc

I hereby certify that this SURVEY and PLAT was made by me or under my direct personal supervision and that I am a duly registered Land Surveyor under the laws of the State of Iowa.

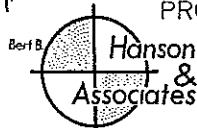

PROFESSIONAL ENGINEERS

LAND SURVEYORS

West Union Independence

..... 197  
Iowa Reg. No.

Project No. Book No. Page