

Section 15-94-12
As referred to in
Engr. T.C. Book

UNITED STATES PUBLIC LAND SURVEY CORNER CERTIFICATE

OF

15

Land Survey Monuments situated in Section 22, Township 94 North, Range 12 West, of the Fifth Principal Meridian, CHICKASAW County, Iowa. Previously recorded in NONE (book, page, document number, etc.)


(Show reason for preparing this certificate, the evidence and detailed procedures used in establishing the corner positions and monumentation found or placed.)

Monument Description and Remarks: NE CORNER, SECTION 22-T94N-R12W:

Found T-Bar with cap.
NW CORNER, SE $\frac{1}{4}$ -NE $\frac{1}{4}$, SECTION 22-T94N-R12W: Set $\frac{1}{2}$ " Rebar
with cap @ Existing Angle Iron Fence corner. Checked Corner
relative to N $\frac{1}{4}$ Corner, NE Corner, E $\frac{1}{4}$ Corner & Post @ Center
of Section.

PLAN - VIEW

(Show a minimum of three reference ties to durable physical objects, relevant monuments and physical conditions that will enable recovery of the corner.)

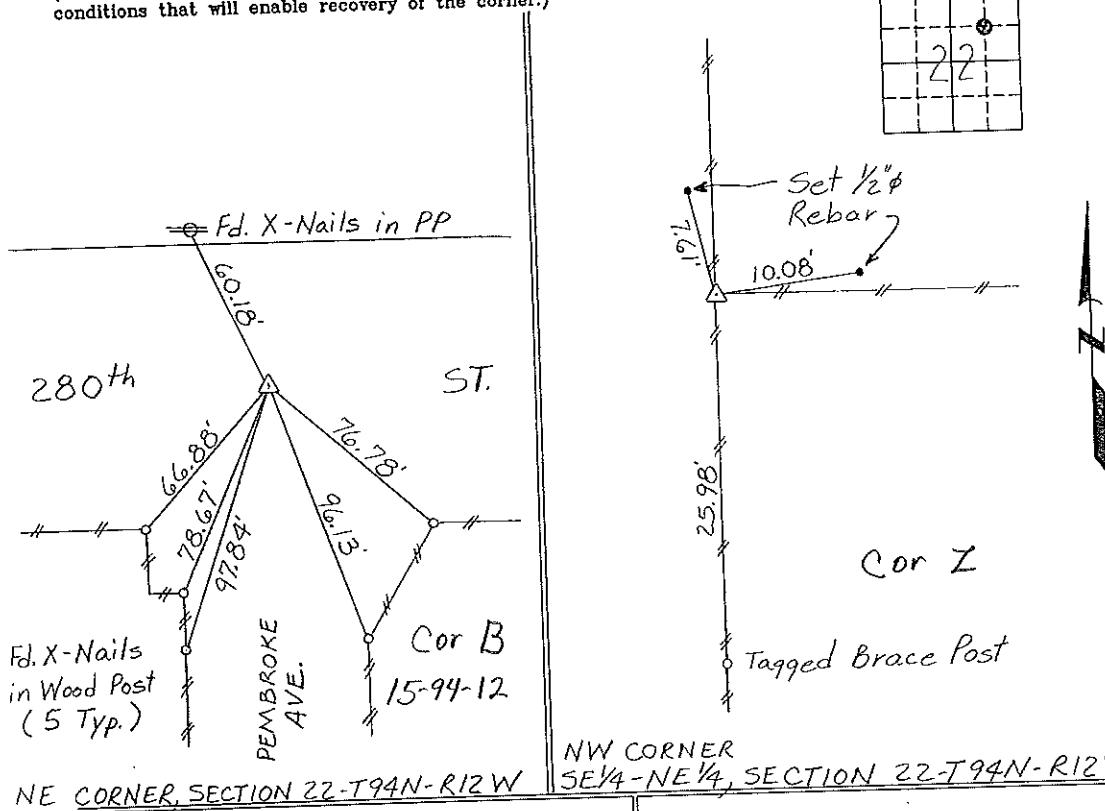

NE CORNER, SECTION 22-T94N-R12W

I hereby certify that the survey work was completed and this certificate was prepared by me or under my direct personal supervision and that I am a duly registered land surveyor under the laws of the state of Iowa.

Signature: Gary L. Casady
Gary L. Casady

Date: 2-8-95 Reg. No. 12532
My Registration Renewal Date is December 31, 1996

Seal



List Corners to be Indexed

Corners	Section	Twp.	Range
NE	22	94N	12W
Cor B	15-94-12		

NW CORNER	SE $\frac{1}{4}$ -NE $\frac{1}{4}$	22	94N	12W
Cor X	22-94-12			

Placed on Tie Bar
3/11/95

BK 152-137

"County Engineer's Copy"