

Instrument #: 2024-0192
 02/12/2024 10:34:27 AM Total Pages: 1
 SCC SECTION CORNER CERTIFICATES
 Recording Fee: \$ 7.00
 Shirley Troyna, Recorder, Chickasaw County Iowa



PREPARED BY / RETURN TO: MIRANDA K. EILDERS IOWA DEPARTMENT OF TRANSPORTATION 428 43rd ST. SW MASON CITY, IA 50401 641-423-7064

UNITED STATES PUBLIC LAND SURVEY CORNER CERTIFICATE
 OF

Land Survey Monuments situated in Section 30, Township 94N, Range 12W
 of the Fifth Principal Meridian, CHICKASAW County, Iowa.

Previously recorded in INST. *2017-2105 & FEE BOOK 2006-0983 in County Recorder's Office.
 (book, page, document number, etc.)


(Show reason for preparing this certificate, the evidence and detailed procedures used in establishing the corner positions and monumentation found or placed.)

Monument Description and Remarks: NW CORNER: REPLACED PREVIOUSLY FOUND SURVEY MARK NAIL/
IDOT STAINLESS STEEL WASHER WITH MAG SPIKE/IDOT SEC. COR. *22293 NEAR C SOUTH BOUND LANE US. 63
PER CERT OF RECORD INST. 2017-2105 AFTER 2023 RESURFACING PROJECT NHSX-063-8(071)--3H-19.
REASON FOR CERT: MONUMENTATION AND HAVE CHANGED.

W 1/4 CORNER: REPLACED PREVIOUSLY FOUND SURVEY MARK NAIL/IDOT WASHER WITH MAG SPIKE/IDOT SEC.
COR. WASHER *22293 4.8' EAST OF C SOUTH BOUND OF US. 63 PER CERT OF RECORD FEE BOOK 2006-0983
AFTER 2023 RESURFACING PROJECT NHSX-063-8(071)--3H-19.
REASON FOR CERT: MONUMENTATION AND TIES HAS HAVE CHANGED.

PLAN - VIEW


(Show a minimum of three reference ties to durable physical objects, relevant monuments and physical conditions that will enable recovery of the corner.)

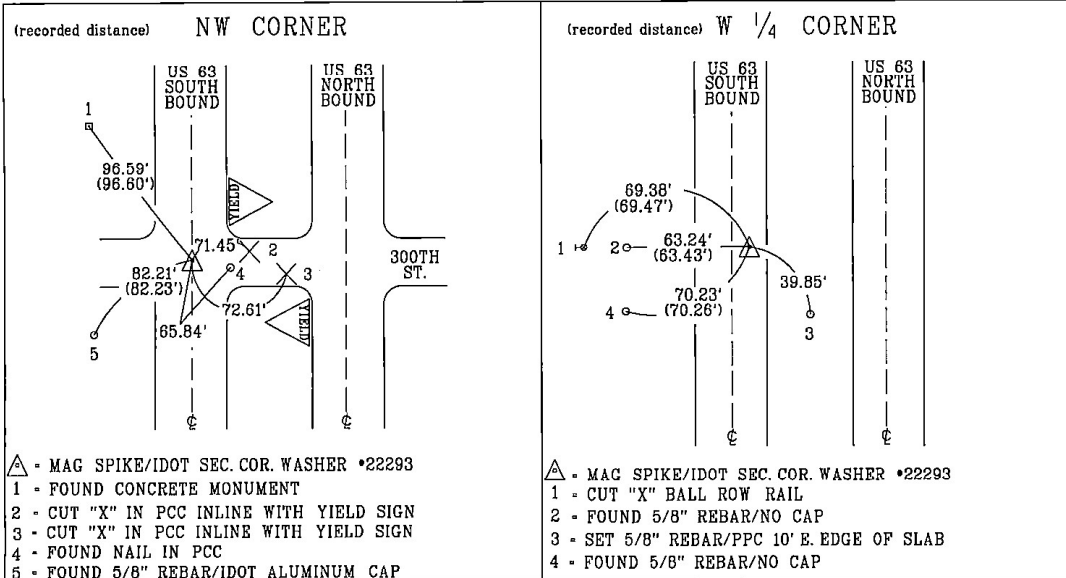

COR D
 25-94-13

COR C
 25-94-13

List Corners to be Indexed			
Corner	Section	Township	Range
NW CORNER	30	94N	12W
W 1/4 CORNER	30	94N	12W


 I hereby certify that this land surveying document was prepared and the related survey work was performed by me or under my personal supervision and that I am duly licensed professional Land Surveyor under the laws of the state of Iowa.
Miranda K. Eilders 1-30-2024
 Miranda K. Eilders Date
 License number 22293
 My License renewal date is December 31, 2025
 Pages or sheets covered by this seal. 1

