

Instr. Number: 2024-1004  
 Recorded: 7/8/2024 at 3:01:50.0 PM  
 Pages 1  
 County Recording Fee: \$7.00  
 Iowa E-Filing Fee: \$3.00  
 Combined Fee: \$10.00  
 Revenue Tax:  
 Shirley Troyna RECORDER  
 Chickasaw County, Iowa

Prepared by & Return to: Kirk D. Reicks, HRS, L.L.C., 18 East Main Street, New Hampton, IA 50659, Phone 641-394-2725

### United States Public Land Survey Corner Certificate

Land Survey Monument situated in  
 Section 30, Township 94 North, Range 12 West of the Fifth Principal Meridian, Chickasaw County, Iowa.  
 On file in Document #2013-1123 in the County Recorder's Office.

This certificate is being prepared in compliance with Iowa Code Chapter 355.11 because:

- There is no certificate on file for this corner.
- There are no longer three valid ties of record.
- There are changes to reference ties of record.
- There is change of monumentation of record.
- To clarify description of record monument (ties).


**Monument Description and Remarks:**

**North 1/4 Corner:**

Found 5/8"Ø Iron Pin matching survey of record distances and existing reference tie distances. Placed 2"Ø Aluminum Cap PLS 19211 on top of 5/8"Ø Iron Pin. Previously recorded Section Corner Certificate Document #2013-1123 indicates 1/2" Square Bar as the monument. A Survey and Plat, as recorded in Document #2013-1121 on file in the County Recorder's Office indicates 1"Ø Iron Pin. Updating Section Corner Certificate to clarify the monument and added ties.

### Plan View - Not to Scale

(Show a minimum of three reference ties to durable physical objects, relevant monuments and physical conditions that will enable recovery of the corner.)

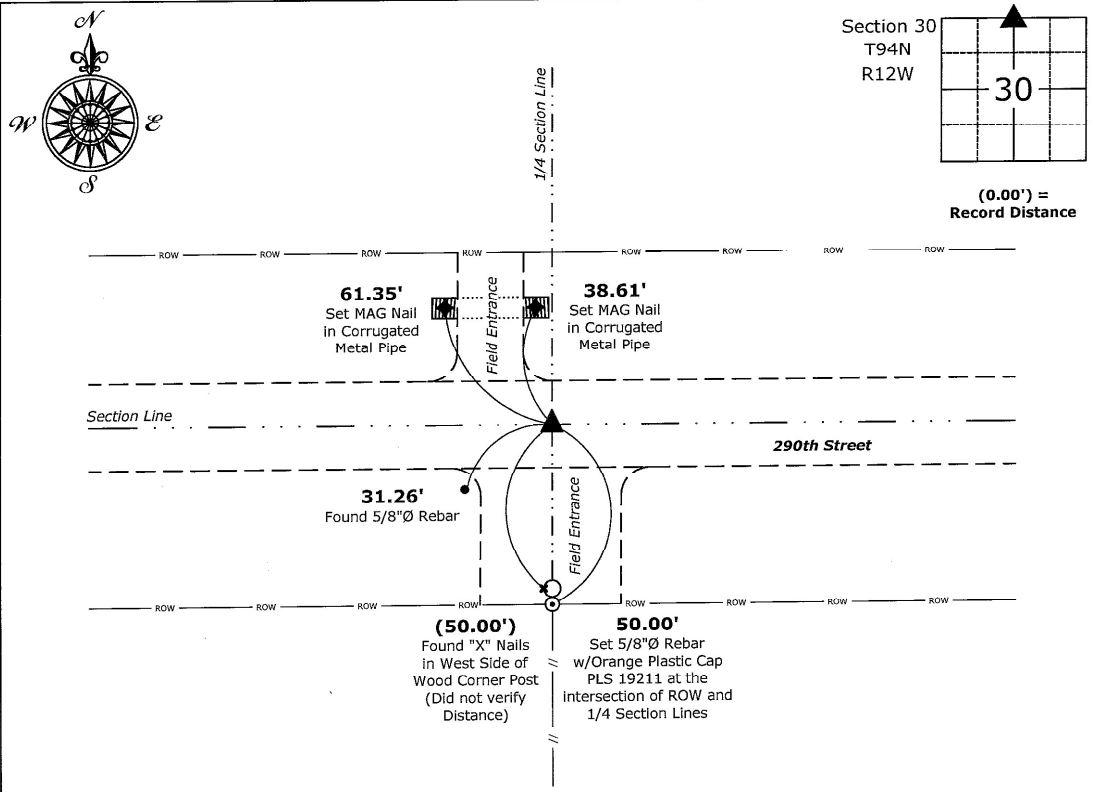


**North 1/4 Corner of Section 30-94-12**

Found 5/8"Ø Iron Pin, Placed 2"Ø Aluminum Cap PLS 19211 on top

COR A  
 19-94-12

File: S:\\_Projects - NHO\County Control Systems - NHO\CHICKASAW\CHICK-49 - 2024.dwg, 7/3/2024 7:47:07 AM

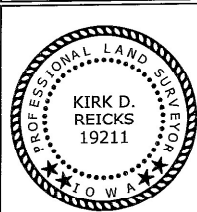

I hereby certify that this land surveying document was prepared and the related survey work was performed by me or under my direct personal supervision and that I am a duly licensed Land Surveyor under the laws of the State of Iowa.

*Kirk D. Reicks* 7-3-2024  
 Kirk D. Reicks Date:  
 License number 19211  
 My license renewal date is December 31, 2024.  
 Sheets covered by this seal: Individual sheet only

List Corner to be Indexed			
Corner	Section	Township	Range
N 1/4	30	94	12
Project Number: 2024-085			
FB: Chickasaw 12, Page(s) 71-72			