

Prepared by & Return to Herold - Ricks Surveying, 10 East Main Street, New Hampton, IA 50659, Ph. 641-394-2725

### UNITED STATES PUBLIC LAND SURVEY CORNER CERTIFICATE

Land Survey Monuments situated in Section <sup>19</sup>30, Township 94 North, Range 12 West of the Fifth Principal Meridian, Chickasaw County, Iowa. 1.) Not previously recorded in the County Recorder's office. 2.) Previously recorded in Doc. #2008-1519 in the County Recorder's office.

This certificate is being prepared in compliance with Iowa Code Chapter 355.11 because:


- 1  There is no certificate on file for this corner.
- There are no longer three valid ties of record.
- 2  There are changes to reference ties of record.
- There is change of monumentation of record.
- To clarify description of record monument (ties).

**Monument Description and Remarks:**

- 1.) **Northeast Corner:** Fd. 5/8"Ø Twisted Iron Bar from Information obtained from the County Engineer's office.
- 2.) **NE Corner SE 1/4-SE 1/4:** Fd. 1/2"Ø Rebar w/1.5"Ø Alum. Cap PLS 11442 from Information obtained from previous Section Corner Certificate; no valid ties remained, set new ties to update corner.


#### PLAN - VIEW

(Show a minimum of three reference ties to durable physical objects, relevant monuments and physical conditions that will enable recovery of the corner.)

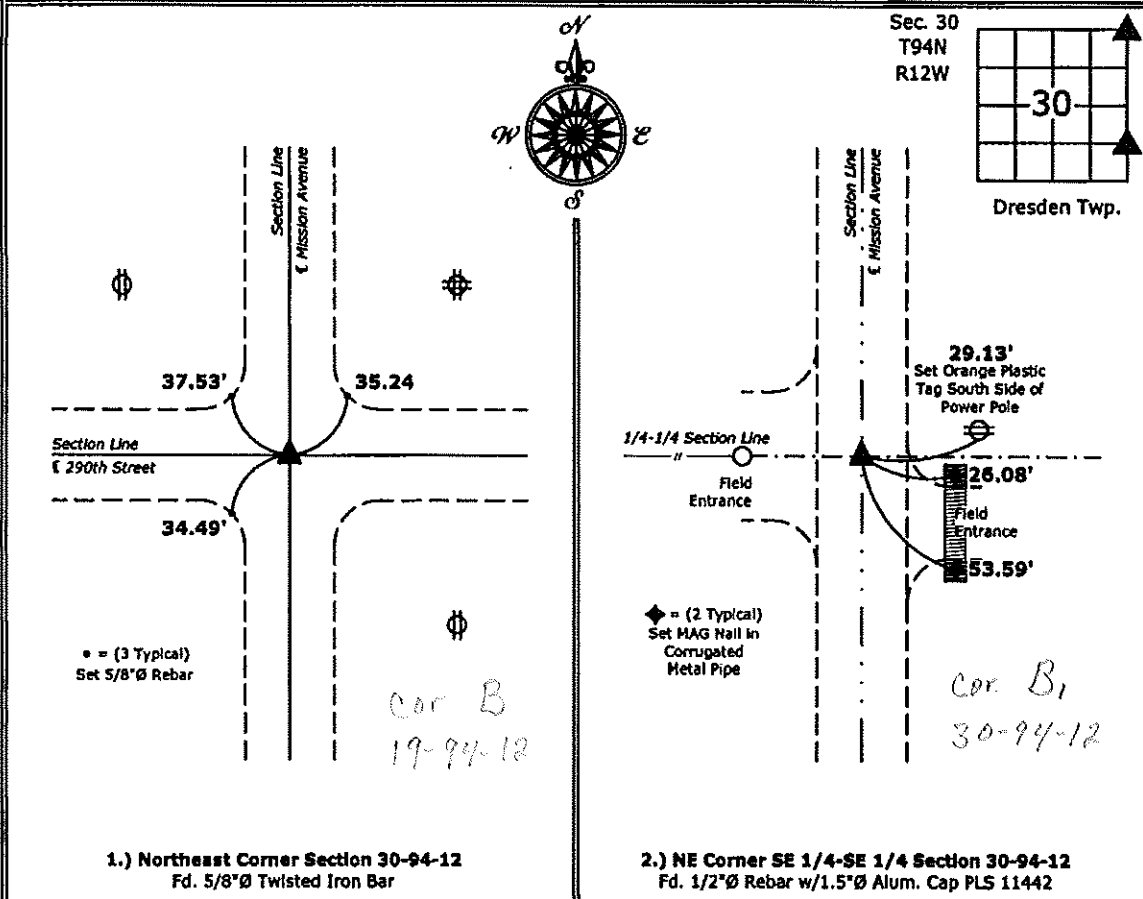

1.) Northeast Corner Section 30-94-12  
 Fd. 5/8"Ø Twisted Iron Bar

2.) NE Corner SE 1/4-SE 1/4 Section 30-94-12  
 Fd. 1/2"Ø Rebar w/1.5"Ø Alum. Cap PLS 11442

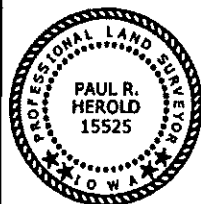

I hereby certify that this land surveying document was prepared and the related survey work was performed by me or under my direct personal supervision and that I am a duly licensed Land Surveyor under the laws of the State of Iowa.

*Paul R. Herold 7-11-13*  
 Paul R. Herold Date:

License number 15525  
 My license renewal date is December 31, 2014.  
 Sheets covered by this seal: Individual sheet only

List Corners to be Indexed			
Corners	Section	Twp.	Range
NE	30	94	12
NE-SE-SE	30	94	12

Project Number: 2013-075  
 FB: Chickasaw County 5, Pgs. 50-51