

Prepared by & Return to: Herold - Reicks Surveying, 10 East Main Street, New Hampton, IA 56656, Ph. 641-394-2725

### UNITED STATES PUBLIC LAND SURVEY CORNER CERTIFICATE

Land Survey Monuments situated in Section 30, Township 94 North, Range 12 West of the Fifth Principal Meridian, Chickasaw County, Iowa. 1.) Previously recorded in Doc. #2008-1525 in the County Recorder's office. 2.) Not previously recorded in the County Recorder's office.

This certificate is being prepared in compliance with Iowa Code Chapter 355.11 because:



- 2  There is no certificate on file for this corner.
- There are no longer three valid ties of record.
- There are changes to reference ties of record.
- 1  There is change of monumentation of record.
- To clarify description of record monument (ties).


**Monument Description and Remarks:**

**1.) Northwest Corner SW 1/4-NW 1/4:** Set Survey Mark Nail w/Stainless Steel Washer PLS 15525 from ties, as shown on previous Section Corner Certificate.

**2.) Northeast Corner SE 1/4-NW 1/4:** Set 5/8"Ø rebar w/2"Ø aluminum cap PLS 15525 equidistant between the North 1/4 and Center of Section 30.


#### PLAN - VIEW

(Show a minimum of three reference ties to durable physical objects, relevant monuments and physical conditions that will enable recovery of the corner.)

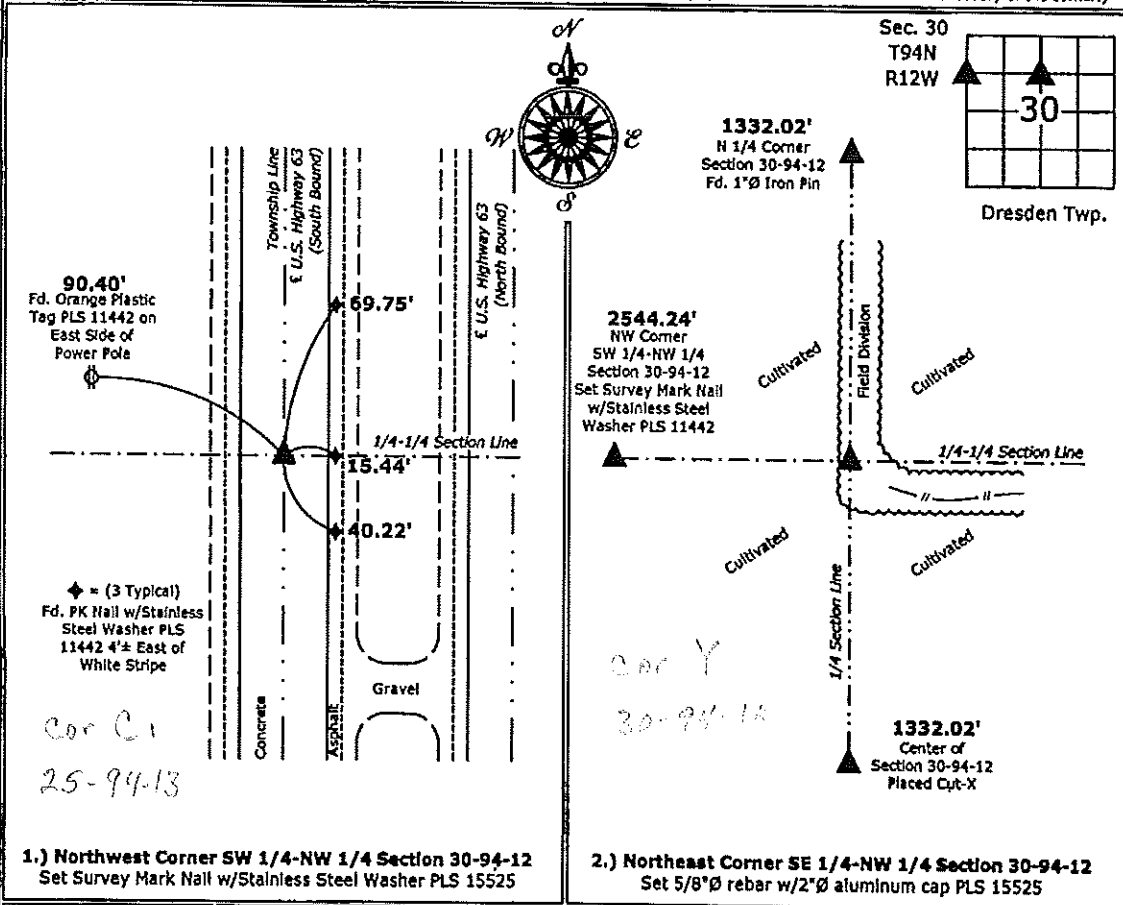

**1.) Northwest Corner SW 1/4-NW 1/4 Section 30-94-12**  
 Set Survey Mark Nail w/Stainless Steel Washer PLS 15525

**2.) Northeast Corner SE 1/4-NW 1/4 Section 30-94-12**  
 Set 5/8"Ø rebar w/2"Ø aluminum cap PLS 15525

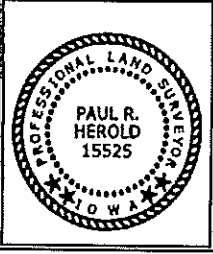

I hereby certify that this land surveying document was prepared and the related survey work was performed by me or under my direct personal supervision and that I am a duly licensed Land Surveyor under the laws of the State of Iowa.

*Paul R. Herold 7-11-13*  
 Paul R. Herold Date:  
 License number 15525  
 My license renewal date is December 31, 2014.  
 Sheets covered by this seal: Individual sheet only

List Corners to be Indexed			
Corners	Section	Twp.	Range
NW-SW-NW	30	94	12
NE-SE-NW	30	94	12

Project Number: 2013-075  
 FB: Chickasaw County 5, Pgs. 50-51