

United Sta	tes Public Land S	Survey Corner Cer	tificate
Section 35, Township 94 Nort	Land Survey Monun h, Range 12 West of the Not on file the County	Fifth Principal Meridian, C	Chickasaw County, Iowa.
This certificate is being prepare with Iowa Code Chapter 355.11	because:	There are no longer three There are changes to refe	e valid ties of record. erence ties of record. mentation of record.
Monument Description and R	emarks:		
West Quarter Corner: County Found 1"Ø Pipe (top bent) and 1 4" x 6" Pointed Brown Granite St high point of said Stone and rem	/2" Square Twisted Bar at tl one with sald 1/2" Square 1	he road surface. Excavated Twisted Bar on the North Sid	18" deep and found a
show a minimum of three reference ties to o	Plan V		the will exchic recovery of the same
N	orable physical objects, relevant in	onuments and physical conditions to	lac will eliable recovery of the coffier.)
Fd. So	Set 5/8"0 Shoulder from Pow (2 Ty) "X" Nalis in theast Side Power Pole Field Entrance	across er Pole	of Post 1/4 Section Line
	Private Drive #3055 N. Sic of Sto	(2"	Spitt Port

West 1/4 Corner of Section 35-94-12 Fd. 4" x 6" Pointed Brown Granite Stone, Placed Cut "X" on the Stone

Date:



I hereby certify that this land surveying document was prepared and the related survey work was performed by me or under my direct personal supervision and that I am a duly licensed Land Surveyor under the laws of the State of Iowa.

Kirk D. Reicks

License number 19211

My license renewal date is December 31, 2022. Sheets covered by this seal: Individual sheet only


List Corner to be Indexed				
Corner	Section	Twp.	Range	
W 1/4	35	94	12	

Project Number: 2020-149 FB: Chickasaw 10, Pgs. 52-53

Projects - NHO\County File: S:\

COUNTY ENGINEER'S SECTION CORNER PRESERVATION RECORD

LAND SURVEY MONUMENT LOCATED IN SECTION ___34, TOWNSHIP 94 N NORTH, RANGE 12 W __, OF THE 5TH P.M.Chickgsqwcounty, IOWA PREVIOUSLY RECORDED __COUNTY_ENGINEER'S_OFFICE _____.

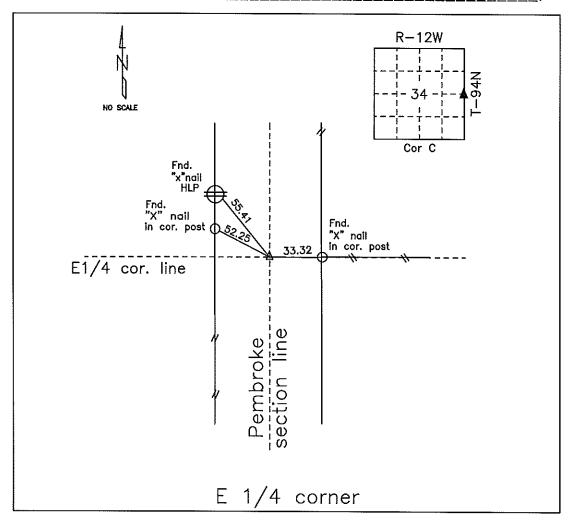

MONUMENT DESCRIPTION AND NARRATIVE Found 1" bent pipe.
Previous record was 4/18/1960 in county tie book.
All ties are slope chained.
I AM NOT A REGISTERED LAND SURVEYOR UNDER THE LAWS OF THE STATE OF IOWA.
JIM FOSTER CHICKASAW CO. DATE: 07/23/09