
Chickasaw Co. Recorder
Cindy Messersmith
Fee Book 2017-1180
07/26/2017 @0931AM
SCC SEC COR CERT
Book: Page: \$7.00 # Pages: 1

Prepared by/Return to: FEHR GRAHAM, 128 S. Vine Street, West Union, IA 52175 - Ph. (563)422-5131

ı

## UNITED STATES PUBLIC LAND SURVEY CORNER CERTIFICATE CHICKASAW COUNTY, IOWA SECTION 11-T94N-R11W

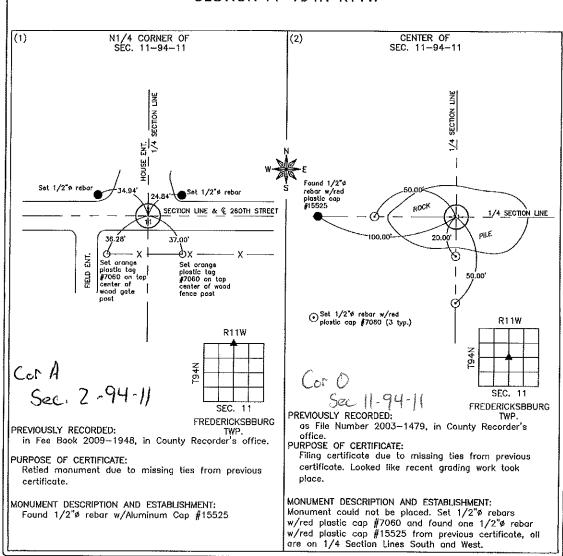

## CORNERS TO BE INDEXED

	CORNER	SECTION	TOWNSHIP	RANGE
(1)	N1/4	11	94N	11W
(2)	CENTER	11	QAN	1 1 W

LYLE G. TEKIPPE TOGO TOWN

I hereby certify that this land surveying document was prepared and the related survey work was performed by me or under my direct personal supervision and that I am a duly licensed Land Surveyor under the laws of the State of Iowa.

> Olay 7-24-17 P.E. & P.M. Date

Lyle C TeKippe, P.E. & P.J. Date Ligense Number: 7080 Date My license renewal date is December 31, 2018. Sheets covered by this seol: Sheet 1


## FEHR GRAHAM

ENGINEERING & ENVIRONMENTAL 02017 FEHR GRAHAM ILLINOIS IOWA WISCONSIN

G:\C30\17\17-592-LS-VICKERY\11-94-11NC.dwg

JOB NUMBER: 17-592

SHEET NUMBER: 1 of 1 Chickasaw Co. Recorder
Cindy Messersmith
Fee Book 2009-1948
10/07/2009 @0233PM
SCC SEC COR CERT
Book: Page: # Pages: 1
Total Fees: \$9.00

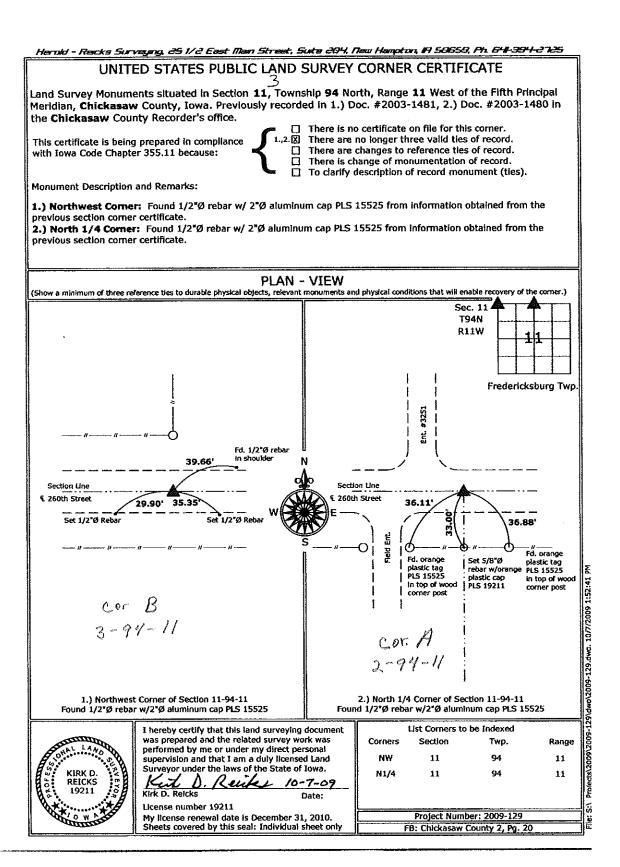

Section 2-94-11 As referred to in Engr. The Book

FILE NO. 2003-1480

798 世7 14 副 9: 28

CINDY MESSERSMITH CHICKASAM CO. FECOADER

TEKIPPE ENGINEERING, P.C., 128 South Vine Street, We	st Union, Iowa	62176 Pho	ne (563) 422	2-6131
UNITED STATES PUBLIC LAND ST	URVEY CO	RNER CE	RTIFICAT	Έ
OF	7-			
Land Survey Monuments situated in Section _		wnship	94 Norti	h. Range
11 West of the Fifth Principal Meridi		IICKASAW		ity, Iowa
Previously recorded in none		in County		. •
(book, page, document num	iber, etc.)	000,	110001401	5 011100
(Show reason for preparing this certificate, the evidence the corner positions and monumentation found or placed		procedures use	d in establis	hing
Monument Description and Remarks: N 1/4 Co.				
indicated in the Chickasaw County Engineer's				
found. Set 1/2"ø rebar w/2"ø aluminum cap				
NW Corner down the Centerline of the road a				
Line fence and intersecting a line extended fr				fashion.
S 1/4 Corner Section 11 T94N R11W: Found 3"ø				_
information obtained from a Corner Stone Sun		Robert R. B	urns, Jr.,	for
Iowa DOT Project, F-18-7(19)21-19, Chickase	aw County.			
PLAN -	VIEW		Project Num FB. 46K P	
(Show a minimum of three reference ties to durable phy	rsical objects, r	relevant monu	nents and p	hysical
conditions that will enable recovery of the corner.)			[	<del>1</del> 1
		Se	ec. 11	+
			194N	11
		;	RIIW	
	5,	Found /8"# rebar @		
Set orange plastic tag PLS 18525		<u>,</u> /	Frederi	cksburg '
SE side 12's Ceder		80		
		^[		
8.8			Set 1/2°¢	
		\\\\-31		
			Section	Line
Section Line		<del>7</del> c	270th St. (U.	S Hwv 18
		5'± [ / ¥		
\ ₹ i / ₩ \ \%				
- " - 0   = 1   0   0   0   0   0   0   0   0   0		l ie		
Set orange Set orange plastic tag plastic tag PLS 15525 PLS 15525		Į į.	Cor	A
top of East   top of wood gate post   comer post		, S	( 0 /	71
		2/ 1/2		
Cor A		م/اٰـــَـــَـــــــــــــــــــــــــــــ	und 5/8°¢ rebar	
2-94-11			Jina 378 y redar '%''s aluminum cos Iowa DOT	P
N 1/4 Corner Section 11 T94N R11W Set 1/2"ø rebor w/2"ø aluminum cap PLS 15525	S 1/4 Found	Corner Section 3"ø aluminum d	11 T94N R11W iisk, lowa DOT	!
	1			·
I hereby certify that this land surveying document	13	lat Corners to		_
was prepared and the related survey work was parformed by me or under my direct personal	Corners	Section	Twp.	Range
supervision and that I am a duly licensed land Surreyor under the laws of the State of Iowa.	N 1/4	11	94N	11W
HEROLD OF THE ACT OF T				
15525 Paul R Herold Date	S 1/4	11	94N	11W
License number 15525	'			
My license renewal date is December Si, 2004. Sheets covered by this seal: Individual	1	Filed 5-		
•	X:\Section Come	rs\Sec. 11\11-94-11	cw.dwg	

County Engineers