

Chickasaw Co. Recorder  
Cindy Messersmith  
**Fee Book 2013-1087**  
07/08/2013 @0121PM  
SCC SEC COR CERT  
Book: Page: # Pages: 1  
Total Fees: \$7.00

PREPARED BY / RETURN TO: KENNETH D. STARK IOWA DEPARTMENT OF TRANSPORTATION 1420 4TH ST. SE MASON CITY, IA 50401 641-423-7684

UNITED STATES PUBLIC LAND SURVEY CORNER CERTIFICATE

OF

11

Land Survey Monuments situated in Section 13, Township 94N, Range 11W  
of the Fifth Principal Meridian, CHICKASAW County, Iowa.

Previously recorded in NA in County Recorder's Office.  
(book, page, document number, etc.)



(Show reason for preparing this certificate, the evidence and detailed procedures used in establishing the corner positions and monumentation found or placed.)

Monument Description and Remarks: NW COR -REPLACED PREVIOUSLY FOUND 2 1/2" IDOT  
ALUMINUM DISC MONUMENT IN ACC WITH A 1" BRASS DISC MONUMENT "IDOT SEC COR" IN PCC  
PAVEMENT 0.78' NORTH OF & AFTER PCC OVERLY PROJECT NHSX-018-7(68)-3H-19 PER IDOT AS  
BUILT PLAN FR-18-7(17)-2G-19. REASON FOR CERT: CHANGE TO MONUMENT & NO CERT OF RECORD.

N 1/4 COR - FOUND 2 1/2" IDOT ALUMINUM DISC MONUMENT ~22' SOUTH OF § 15" DEEP PER  
IDOT AS BUILT PLAN FR-18-7(17)--2G-19. REASON FOR CERT: NO CERT ON RECORD.

## PLAN - VIEW

Show a minimum of three reference ties to durable physical objects, relevant monuments and physical conditions that will enable recovery of the corner.

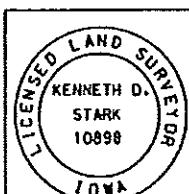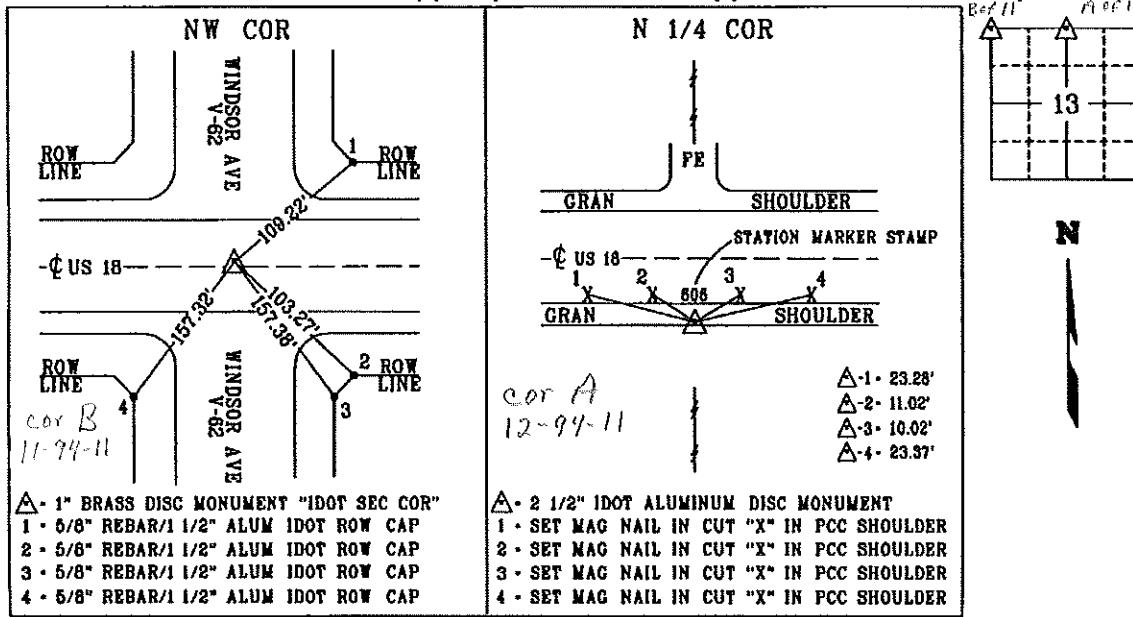

I hereby certify that this land surveying document was prepared and the related survey work was performed by me or under my personal supervision and that I am a duly licensed Land Surveyor under the laws of the state of Iowa.

*Kenneth D. Stark* **07-02-13**

Kenneth D. Stark  
License number 10898  
My License renewal date is December 31, 2013  
None or sheets covered by this seal.

List Corners to be Indexed				
Corner	Section	Township	Range	
NW CORNER	13	94N	11W	
N 1/4 CORNER	13	94N	11W	

Section 12-94-11  
As reserved to in  
Eng. Tie Book

Chickasaw Co., Recorder  
Cindy Messersmith  
**Fee Book 2008-1419**  
07/21/2008 @0200PM  
SCC SEC COR CERT  
Book: Page: Total Fees: \$7.00 # Pages: 1

Harold - Reicks Surveying, 25 1/2 East Main Street, Suite 204, New Hampton, IA 50659, Ph. 641-394-2725

## UNITED STATES PUBLIC LAND SURVEY CORNER CERTIFICATE

Land Survey Monuments situated in Section **13**, Township **94** North, Range **11** West of the Fifth Principal Meridian, **Chickasaw** County, Iowa. Previously not recorded in the Chickasaw County Recorder's office.

This certificate is being prepared in compliance with Iowa Code Chapter 355.11 because:


- There is no certificate on file for this corner.
- There are no longer three valid ties of record.
- There are changes to reference ties of record.
- There is change of monumentation of record.
- To clarify description of record monument (ties).

### Monument Description and Remarks:

N 1/4 Corner Section 13-94-11: Fd. I.D.O.T. Alum. Monument, Corner located from information on a Iowa Department of Transportation Land Corner Survey, made by Robert R. Burns, signed February 12, 1979, on this Plat the monument was indicated that it was a Concrete Monument, it was later raised and the Alum. Monu. was set by the I.D.O.T. as part of a shoulder widening project.


### PLAN - VIEW

(Show a minimum of three reference ties to durable physical objects, relevant monuments and physical conditions that will enable recovery of the corner.)

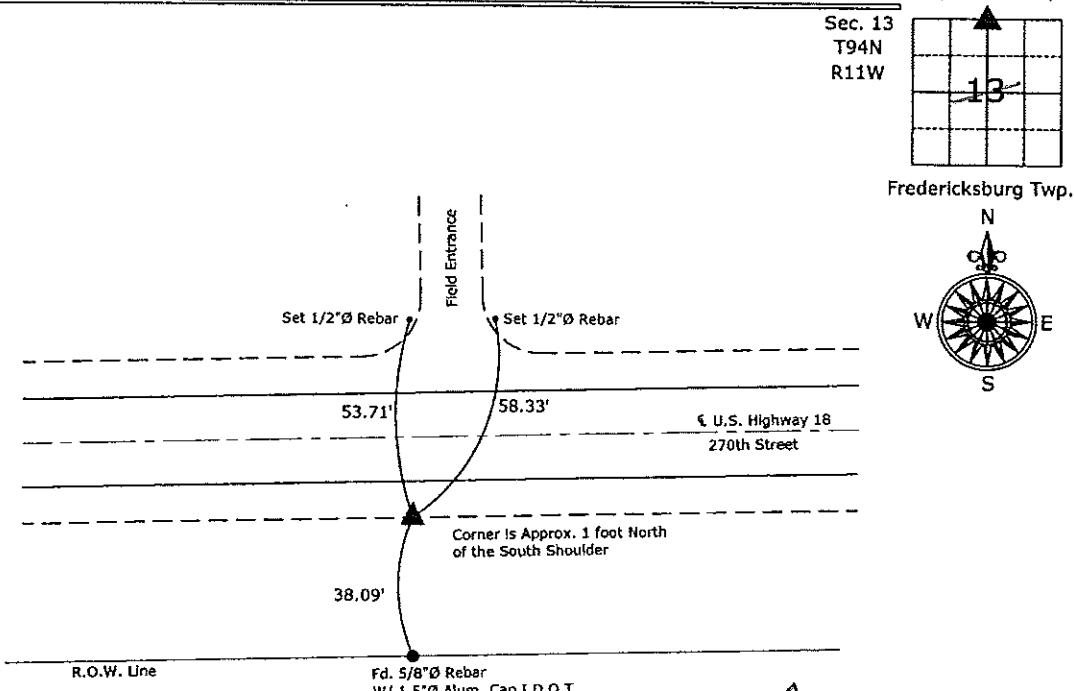

Cor A  
12-94-11

N 1/4 Corner Section 13-94-11  
Fd. I.D.O.T. Alum. Monument

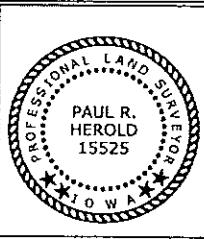

I hereby certify that this land surveying document was prepared and the related survey work was performed by me or under my direct personal supervision and that I am a duly licensed Land Surveyor under the laws of the State of Iowa.

Paul R. Herold 7-21-08

Paul R. Herold Date:

License number 15525

My license renewal date is December 31, 2008.  
Sheets covered by this seal: Individual sheet only

List Corners to be Indexed			
Corners	Section	Twp.	Range
N 1/4	13	94	11
Project Number: 2008-077			
FB: Chickasaw County 1, Pg. 73			