

PREPARED BY / RETURN TO: KENNETH D. STARK IOWA DEPARTMENT OF TRANSPORTATION 1420 4th ST. SE MASON CITY, IA 50401 641-423-7584

**UNITED STATES PUBLIC LAND SURVEY CORNER CERTIFICATE**

OF  
12

Land Survey Monuments situated in Section 13, Township 94N, Range 11W  
 of the Fifth Principal Meridian, CHICKASAW County, Iowa.


Previously recorded in NA in County Recorder's Office.  
(book, page, document number, etc.)

(Show reason for preparing this certificate, the evidence and detailed procedures used in establishing the corner positions and monumentation found or placed.)

Monument Description and Remarks: NE COR - REPLACED PREVIOUS FOUND 2 1/2" IDOT  
ALUMINUM DISC MONUMENT IN ACC WITH A 1" BRASS DISC MONUMENT "IDOT SEC COR" ON C IN  
PCC PAVEMENT AFTER OVERLAY PROJECT NSHX-018-7(58)--3H-19 PER IDOT AS BUILT PLAN  
NHS-18-8(28)--19-33. REASON FOR CERT: CHANGE TO MONUMENT AND NO CERT OF RECORD.


**PLAN - VIEW**

Show a minimum of three reference ties to durable physical objects, relevant monuments and physical conditions that will enable recovery of the corner.

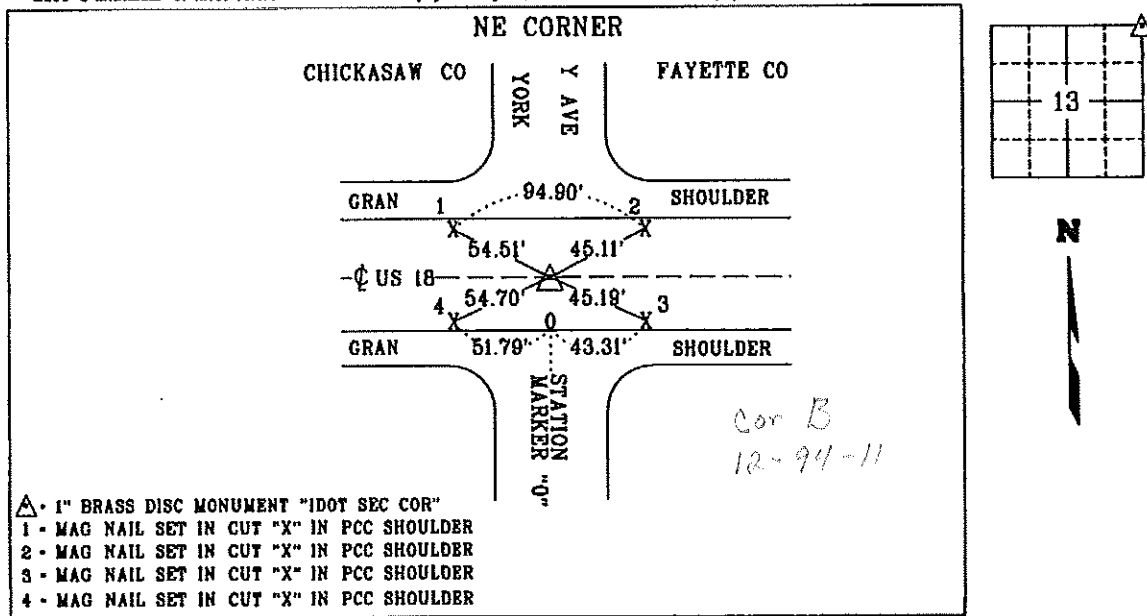

List Corners to be indexed

Corner	Section	Township	Range
NE CORNER	13	94N	11W

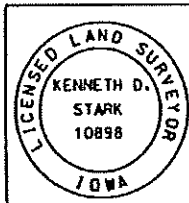

I hereby certify that this land surveying document was prepared and the related survey work was performed by me or under my personal supervision and that I am a duly Licensed Land Surveyor under the laws of the state of Iowa.

*Kenneth D. Stark* 07-02-13  
 Kenneth D. Stark Date  
 License number 10898  
 My License renewal date is December 31, 2013  
 Pages or sheets covered by this seal: 1