

PREPARED BY / RETURN TO: KENNETH D. STARK IOWA DEPARTMENT OF TRANSPORTATION 1430 4th ST. SE MASON CITY, IA 50401 641-423-7584

UNITED STATES PUBLIC LAND SURVEY CORNER CERTIFICATE

OF

Land Survey Monuments situated in Section 14, Township 94N, Range 11W
 of the Fifth Principal Meridian, CHICKASAW County, Iowa.

Previously recorded in BOOK 151, PAGE 48 in County Recorder's Office.
(book, page, document number, etc.)


(Show reason for preparing this certificate, the evidence and detailed procedures used in establishing the corner positions and monumentation found or placed.)

Monument Description and Remarks: NW COR - REPLACED PREVIOUSLY FOUND 2 1/2" IDOT ALUMINUM DISC MONUMENT IN ACC WITH A 1" BRASS DISC MONUMENT "IDOT SEC COR" IN PCC PAVEMENT 12.47' SOUTH OF C AFTER PCC OVERLAY PROJECT NHSX-018-7(58)--3H-19 PER PREVIOUS CERT BOOK 151, PAGE 48. REASON FOR CERT: CHANGE TO MONUMENT.

N 1/4 COR - REPLACED PREVIOUSLY FOUND 2 1/2" IDOT ALUMINUM DISC MONUMENT IN ACC WITH A 1" BRASS DISC MONUMENT "IDOT SEC COR" IN PCC PAVEMENT 4.85' NORTH OF C AFTER PCC OVERLAY PROJECT NHSX-018-7(58)--3H-19 PER IDOT AS BUILT PLAN FR-18-7(17)--2G-19. REASON FOR CERT: CHANGE TO MONUMENT AND NO CERT OF RECORD.


PLAN - VIEW

(Show a minimum of three reference ties to durable physical objects, relevant monuments and physical conditions that will enable recovery of the corner.)

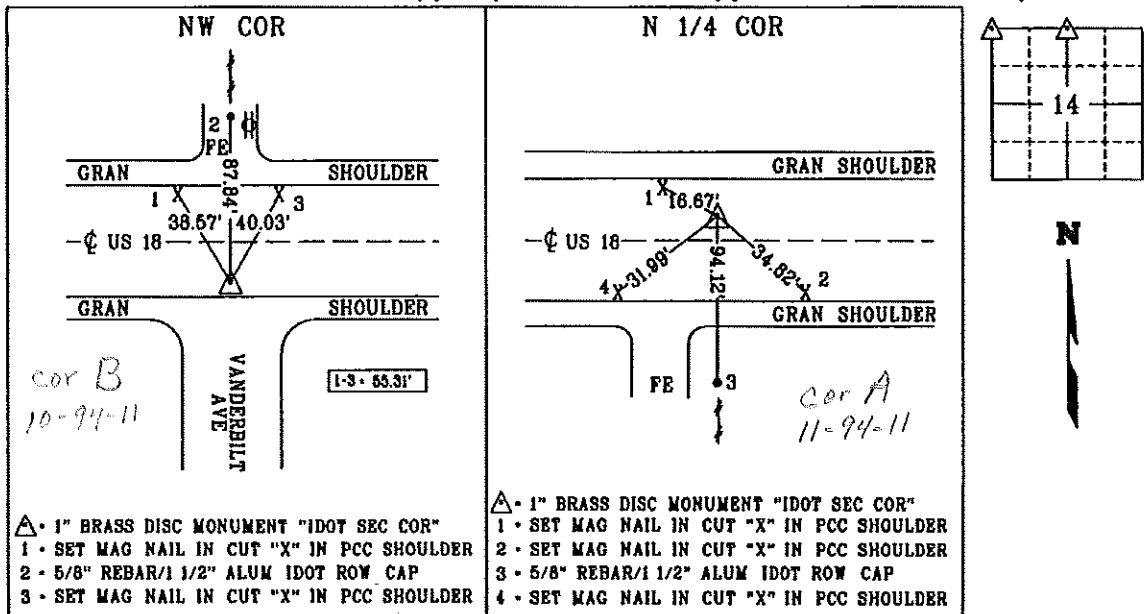

- ▲ 1" BRASS DISC MONUMENT "IDOT SEC COR"
- 1 - SET MAG NAIL IN CUT "X" IN PCC SHOULDER
 - 2 - 5/8" REBAR/1 1/2" ALUM IDOT ROW CAP
 - 3 - SET MAG NAIL IN CUT "X" IN PCC SHOULDER

- ▲ 1" BRASS DISC MONUMENT "IDOT SEC COR"
- 1 - SET MAG NAIL IN CUT "X" IN PCC SHOULDER
 - 2 - SET MAG NAIL IN CUT "X" IN PCC SHOULDER
 - 3 - 5/8" REBAR/1 1/2" ALUM IDOT ROW CAP
 - 4 - SET MAG NAIL IN CUT "X" IN PCC SHOULDER

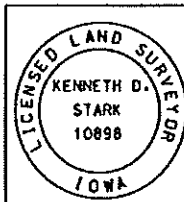

I hereby certify that this land surveying document was prepared and the related survey work was performed by me or under my personal supervision and that I am a duly licensed Land Surveyor under the laws of the state of Iowa.
Kenneth D. Stark 07-02-13
 Kenneth D. Stark Date
 License number 10898
 My License renewal date is December 31, 2013
 Pages or sheets covered by this seal: 1

List Corners to be Indexed

Corner	Section	Township	Range
NW CORNER	14	94N	11W
N 1/4 CORNER	14	94N	11W

TIED: DM DRAWN: ME