

Chickasaw Co. Recorder
 Cindy Messersmith
 Fee Book 2016-0078
 01/18/2016 @0944AM
 SCC SEC COR CERT # Pages: 1
 Book: Page: \$7.00
 Total Fees:

PREPARED BY / RETURN TO: KENNETH D. STARK IOWA DEPARTMENT OF TRANSPORTATION 428 43rd ST. SW MASON CITY, IA 50401 641-423-7584

UNITED STATES PUBLIC LAND SURVEY CORNER CERTIFICATE

OF

Land Survey Monuments situated in Section 18, Township 94N, Range 11W
 of the Fifth Principal Meridian, CHICKASAW County, Iowa.

Previously recorded in Doc. No. 00855 - Book 149, Page 463 in County Recorder's Office.
(book, page, document number, etc.)

(Show reason for preparing this certificate, the evidence and detailed procedures used in establishing the corner positions and monumentation found or placed.)

Monument Description and Remarks: NW CORNER: Replaced previously found IDOT Alum Disc with a Survey Mark Nail/IDOT Sec. Cor. washer, on \oslash US 18 per previous cert of record Doc. No. 00855 after HMA resurfacing project NHSX-018-7(62)--3H-19.


Reason for cert: Monumentation and ties have changed.

N¹/₄ CORNER: Replaced previously found IDOT Alum Disc with a Survey Mark Nail/IDOT Sec. Cor. washer, 0.6' +/- North \oslash US 18 per previous cert of record Book 149, Page 463 after HMA resurfacing project NHSX-018-7(62)--3H--19.

Reason for cert: Monumentation and ties have changed.

PLAN - VIEW

(Show a minimum of three reference ties to durable physical objects, relevant monuments and physical conditions that will enable recovery of the corner.)

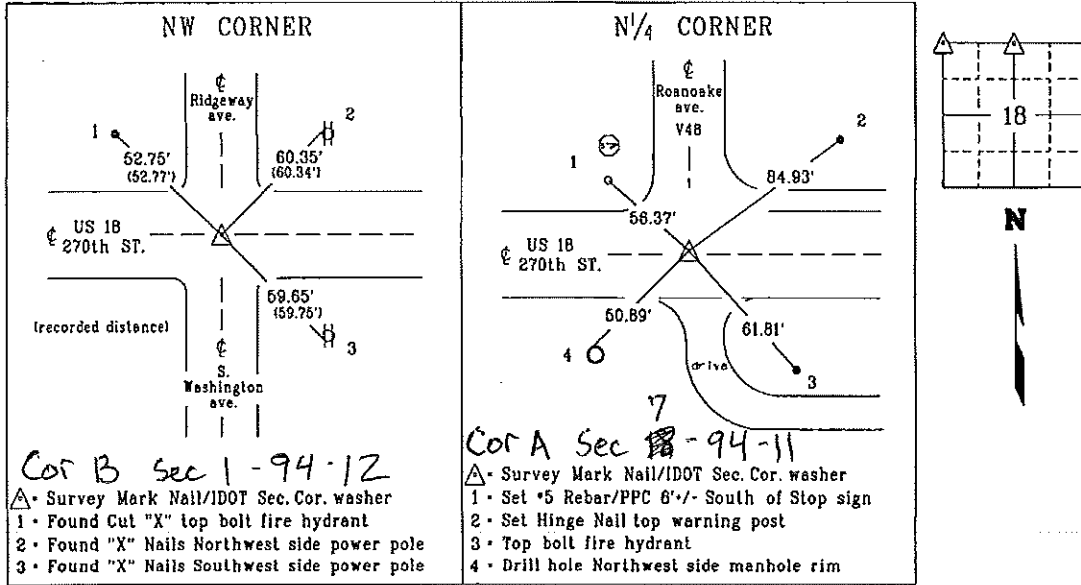

I hereby certify that this land surveying document was prepared and the related survey work was performed by me or under my personal supervision and that I am duly licensed Land Surveyor under the laws of the state of Iowa.

Kenneth D. Stark 01-15-16
 Kenneth D. Stark Date
 License number 10898
 My license renewal date is December 31, 2017
 Pages or sheets covered by this seal. 1

List Corners to be indexed

Corner	Section	Township	Range
NW CORNER	18	94N	11W
N ¹ / ₄ CORNER	18	94N	11W

PPC - Pink Plastic Cap

drawn by: cjs 01/16

19-18-94-11

filed by: me:cs
 right-of-way