

Chickasaw Co. Recorder
 Cindy Messersmith
 Fee Book 2013-1091
 07/08/2013 @0139PM
 SEC COR CERT
 Book: Page: # Pages: 1
 Total Fees: \$7.00

PREPARED BY / RETURN TO: KENNETH D. STARK IOWA DEPARTMENT OF TRANSPORTATION 1420 4th ST. SE MASON CITY, IA 50401 641-423-7584
 UNITED STATES PUBLIC LAND SURVEY CORNER CERTIFICATE

OF

8

Land Survey Monuments situated in Section 17, Township 94N, Range 11W
 of the Fifth Principal Meridian, CHICKASAW County, Iowa.

Previously recorded in *2001-2823 & BOOK 172, PAGE 295 in County Recorder's Office.
 (Book, page, document number, etc.)


(Show reason for preparing this certificate, the evidence and detailed procedures used in establishing the corner positions and monumentation found or placed.)

Monument Description and Remarks:

NW COR - REPLACED PREVIOUSLY FOUND 1/2" REBAR & 2" ALUMINUM CAP #15525 IN CORE HOLE
 WITH A 1" BRASS DISC MONUMENT "IDOT SEC COR" AFTER PCC OVERLAY PROJECT
 NHSX-018-7(58)--3H-19 PER PREVIOUS CERT #2002-2823. REASON FOR CERT: CHANGE TO MONUMENT.
 N 1/4 COR - REPLACED PREVIOUSLY FOUND 2 1/2" IDOT ALUMINUM DISC MONUMENT IN ACC
 WITH A 1" BRASS DISC MONUMENT "IDOT SEC COR" 0.76' SOUTH OF C IN PCC PAVEMENT AFTER
 PCC OVERLAY PROJECT NHSX-018-7(58)--3H-19 PER PREVIOUS CERT BOOK 172, PAGE 295.
 REASON FOR CERT: CHANGE TO MONUMENT.


PLAN - VIEW

(Show a minimum of three reference ties to durable physical objects, relevant monuments and physical conditions that will enable recovery of the corner.)

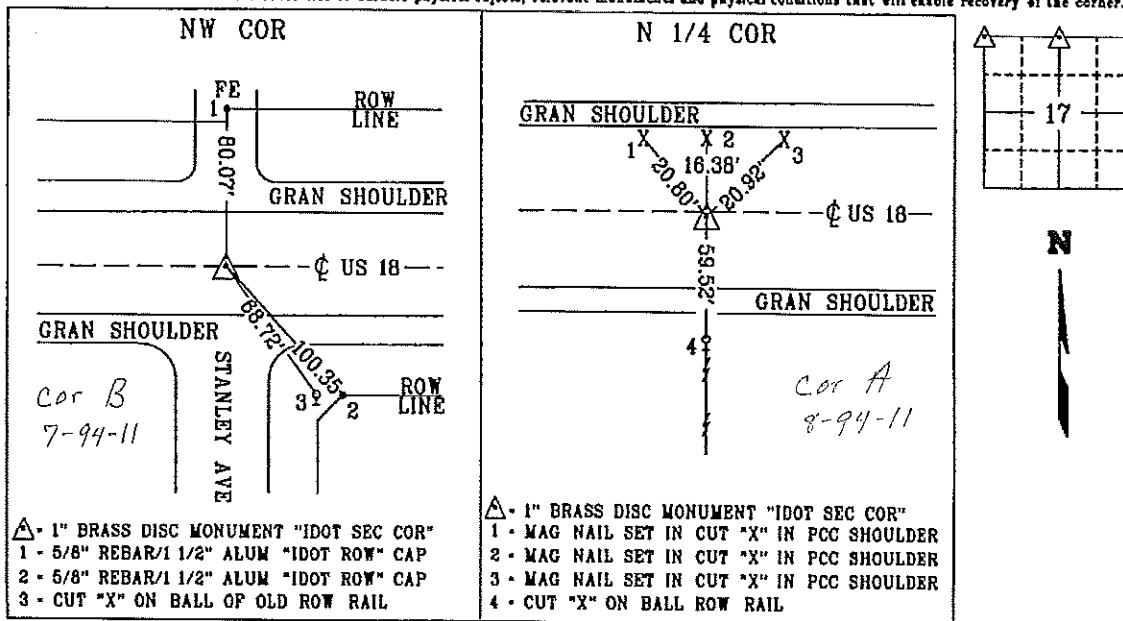

List Corners to be Indexed

Corner	Section	Township	Range
NW CORNER	17	94N	11W
N 1/4 CORNER	17	94N	11W

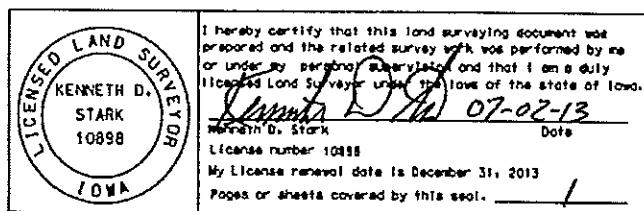

Section 7-94-11
As referred to in
Engg. Tie Back

FILED 2001-2823
RECORDER'S OFFICE
CHICKASAW COUNTY, IOWA

2001 DEC 26 AM 9 14

CINDY MESSERSMITH
COUNTY RECORDER

TEKIPPE ENGINEERING, P.C., 128 South Vine Street, West Union, Iowa 52175 Phone (663) 422-5131

UNITED STATES PUBLIC LAND SURVEY CORNER CERTIFICATE

OF 7

Land Survey Monuments situated in Section 18, Township 94 North, Range 11 West of the Fifth Principal Meridian, CHICKASAW County, Iowa. Previously recorded in Book 156, Page 97 in County Recorder's Office. (book, page, document number, etc.)


(Show reason for preparing this certificate, the evidence and detailed procedures used in establishing the corner positions and monumentation found or placed.)

Monument Description and Remarks: NE Corner Section 18 T94N R11W: Set 1/2"Ø rebar w/2"Ø aluminum cap PLS 15525 from reference ties indicated on the previous Section Corner Certificate recorded in the Chickasaw County Recorder's Office in Book 156, Page 97. The Iowa DOT aluminum monument noted in the previous Section Corner Certificate was missing.

PLAN - VIEW

Project Number 01172.LS
FB. 46 I PG. 41-43 Cor. B
Sec. 7

(Show a minimum of three reference ties to durable physical objects, relevant monuments and physical conditions that will enable recovery of the corner.)

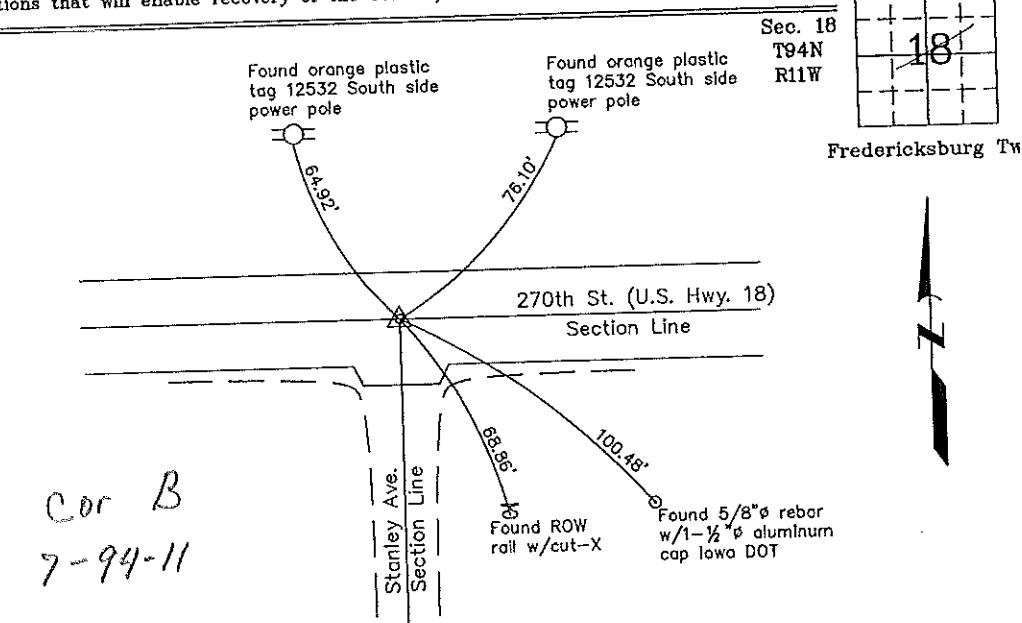

NE Corner Section 18 T94N R11W
Set 1/2"Ø rebar w/2"Ø aluminum cap PLS 15525



I hereby certify that this land surveying document was prepared and the related survey work was performed by me or under my direct personal supervision and that I am a duly licensed Land Surveyor under the laws of the State of Iowa.
Paul R. Herold 12-21-01
Paul R. Herold
License number 15525
My license renewal date is December 31, 2002.
Sheets covered by this seal: Individual

List Corners to be Indexed			
Corners	Section	Twp.	Range
NE	18	94N	11W

Entered 1-10-02

County Engineer
Copy

Section 7-94-11
As referred to in
Engr. Tr. Book

UNITED STATES PUBLIC LAND SURVEY CORNER CERTIFICATE

OF



Land Survey Monuments situated in Section 18⁷, Township 94 NORTH, Range 11 WEST, of the Fifth Principal Meridian, CHICKASAW County, Iowa.
Previously recorded in NONE in County Recorder's Office.

(book, page, document number, etc.)
(Show reason for preparing this certificate, the evidence and detailed procedures used in establishing the corner positions and monumentation found or placed.)

Monument Description and Remarks: NE CORNER, SECTION 18-T94N-R11W:
Found IDOT Aluminum Monument.

PLAN - VIEW

(Show a minimum of three reference ties to durable physical objects, relevant monuments and physical conditions that will enable recovery of the corner.)

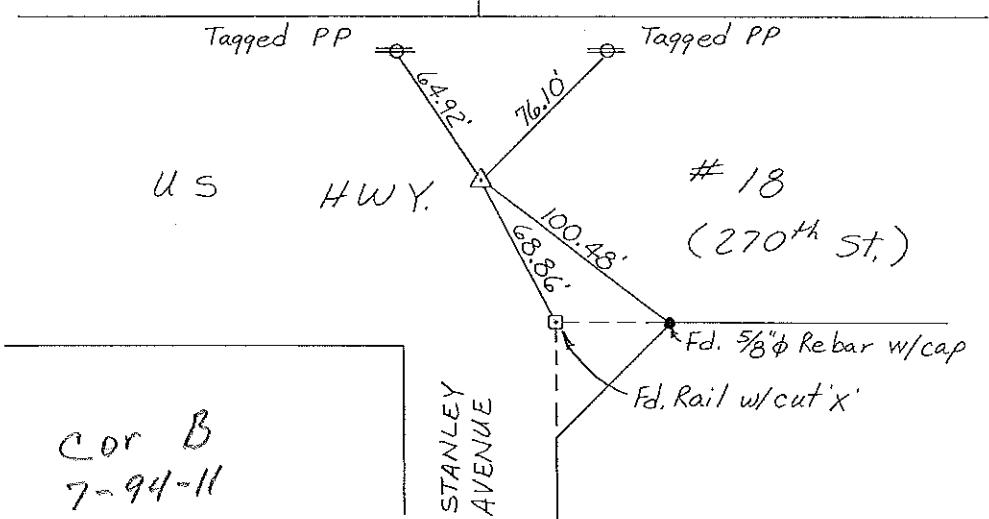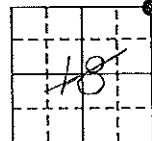

I hereby certify that the survey work was completed and this certificate was prepared by me or under my direct personal supervision and that I am a duly registered land surveyor under the laws of the state of Iowa.

Signature: Gary L. Casady
Name typed or printed: Gary L. Casady

Date: 9-26-94 Reg. No. 12532

My Registration Renewal Date is December 31, 1994

SEAL



Corners	Section	Twp	Range
NE	18	94N	11W

Corner B 7-94-11
Placed in the
Book 10/21/94

"County Engineer's Copy"

UNITED STATES PUBLIC LAND SURVEY CORNER CERTIFICATE

SECTION 17⁷, TOWNSHIP 94, RANGE 11 OF THE 5TH. P.M.
IN CHICKASAW COUNTY, IOWA

CORNER: NW COR NW1/4

DESCRIPTION AND REMARKS:

FOUND ALUMINUM CORE



*Placed in
Tie Book 4/31
JFM*

PREVIOUSLY RECORDED IN BOOK _____, PAGE _____

PLAN VIEW



NO SCALE

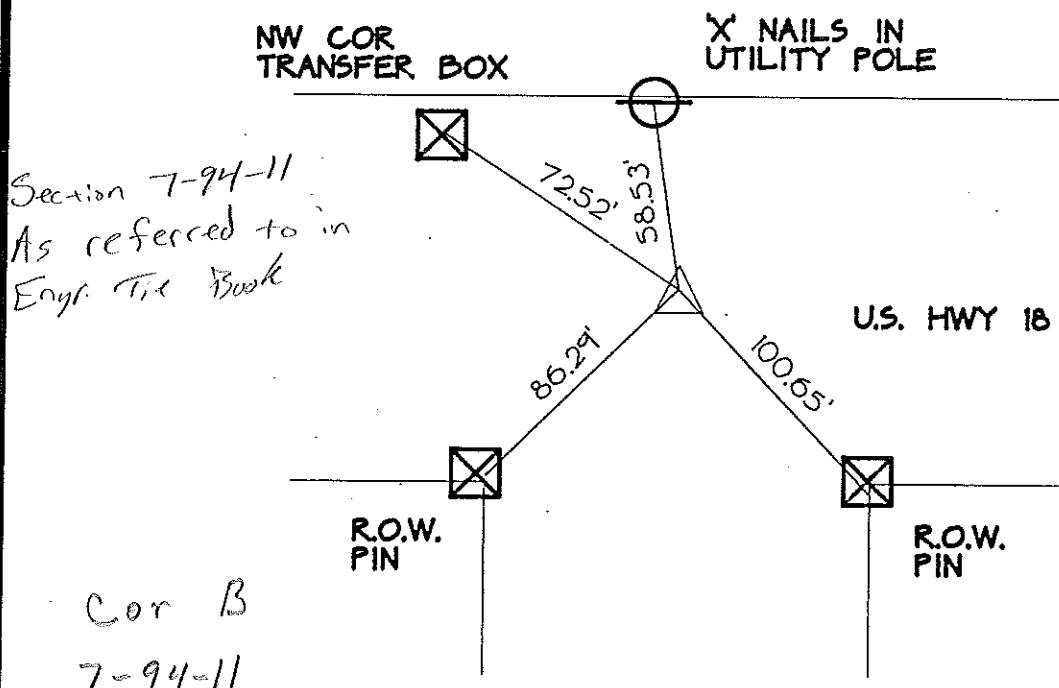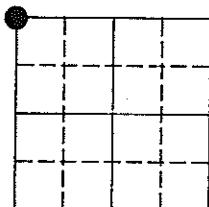

CERTIFICATION:
I HEREBY CERTIFY THAT THIS MAP, PLAT, OR SURVEY WAS MADE BY
ME OR UNDER MY DIRECT PERSONAL SUPERVISION AND THAT I AM A
DULY REGISTERED LAND SURVEYOR UNDER THE LAWS OF THE STATE
OF IOWA.

Thomas V. Craft
THOMAS V. CRAFT REG. L.S. NO. 7549

DATE: 4/17/91



INDEXING ALTERNATIVES

CORNER	SECTION	TWP	RANGE
NE	18	94	11
SE	7	94	11
SW	8	94	11

MCN/012710

Howard R. Green Company, Charles City, Iowa