

FILED 2001-1796
 RECORDER'S OFFICE
 CHICKASAW COUNTY, IOWA

2001 AUG 21 AM 10 31

CINDY MESSERSMITH
 COUNTY RECORDER

TeKIPPE ENGINEERING, P.C., 128 South Vine Street, West Union, Iowa 52175 Phone (563) 422-5131

UNITED STATES PUBLIC LAND SURVEY CORNER CERTIFICATE

OF

Land Survey Monuments situated in Section 21, Township 94 North, Range 11 West of the Fifth Principal Meridian, CHICKASAW County, Iowa. Previously recorded in none in County Recorder's Office. (book, page, document number, etc.)

(Show reason for preparing this certificate, the evidence and detailed procedures used in establishing the corner positions and monumentation found or placed.)


Monument Description and Remarks: N 1/4 Corner Section 21 T94N R11W: Found bent 60d nail with information obtained from the Chickasaw County Engineer's Office in the Field Book Fredericksburg Twp. Corner Ties, Section 16, Corner A. Removed nail. Set 1/2"Ø rebar w/2"Ø aluminum cap PLS 15525 in same location.

S 1/4 Corner Section 21 T94N R11W: Found T-bar with information obtained from the Chickasaw County Engineer's Office in the Field Book Fredericksburg Twp. Corner Ties, Corner A.

PLAN - VIEW

Project Number 01121.15
 FB. NRCS 2 PG. 4-8

(Show a minimum of three reference ties to durable physical objects, relevant monuments and physical conditions that will enable recovery of the corner.)

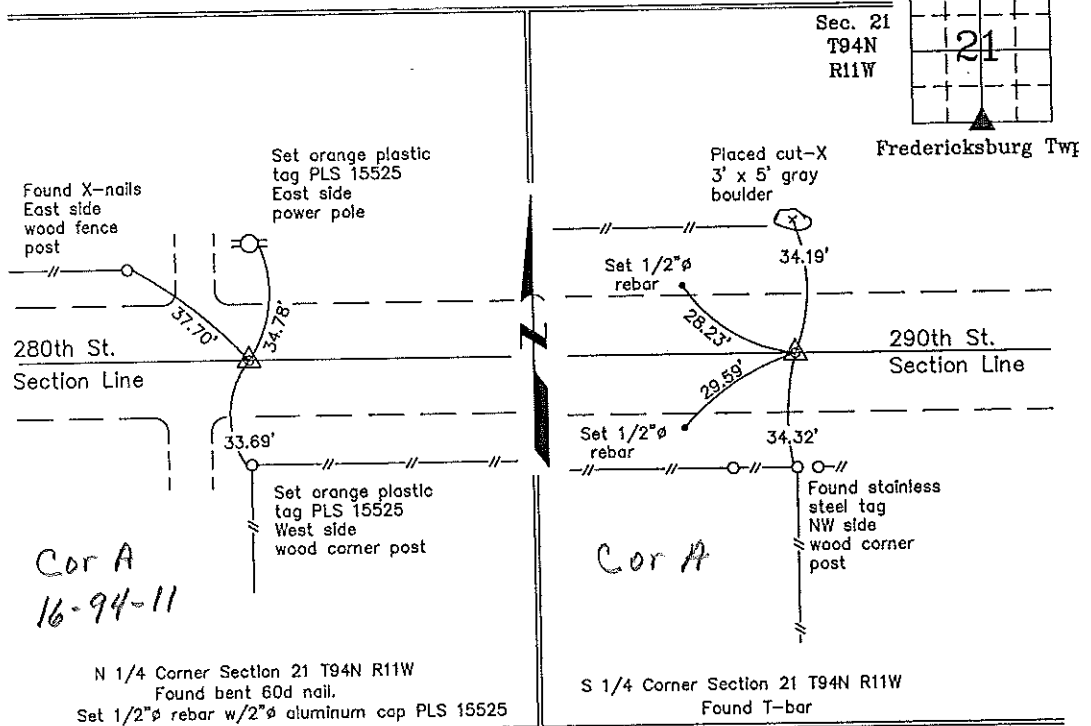

I hereby certify that this land surveying document was prepared and the related survey work was performed by me or under my direct personal supervision and that I am a duly licensed Land Surveyor under the laws of the State of Iowa.

Paul R. Herold 8-20-01
 Paul R. Herold Date
 License number 15525
 My license renewal date is December 31, 2002.
 Sheets covered by this seal: Individual

List Corners to be Indexed			
Corners	Section	Twp.	Range
N 1/4	21	94	11
S 1/4	21	94	11

Filed 10-10-01

County Engineer's
 Copy