

2003 AUG 22 AM 9 06

CINDY MESSERSMITH
 COUNTY RECORDER

TeKIPPE ENGINEERING, P.C., 128 South Vine Street, West Union, Iowa 52175 Phone (563) 422-6131

UNITED STATES PUBLIC LAND SURVEY CORNER CERTIFICATE

OF
 Land Survey Monuments situated in Section 24, Township 94 North, Range
11 West of the Fifth Principal Meridian, CHICKASAW County, Iowa.
 Previously recorded in none in County Recorder's Office.
(book, page, document number, etc.)

(Show reason for preparing this certificate, the evidence and detailed procedures used in establishing the corner positions and monumentation found or placed.)



Monument Description and Remarks: **E 1/4 Corner Section 24 T94N R11W:** Found 1/2"Ø rebar w/orange plastic cap 6505.
SE Corner Section 24 T94N R11W: Found 1/2"Ø rebar w/1-1/2"Ø aluminum cap Fayette County.

NOTE: Both Corners were found with information obtained from a Survey and Plat made by Paul Helland recorded in the Chickasaw County Recorder's Office in Deed Book 156, Page 88.

PLAN - VIEW

Project Number 03157.LS
 FB. 46K PG. 18-20

(Show a minimum of three reference ties to durable physical objects, relevant monuments and physical conditions that will enable recovery of the corner.)

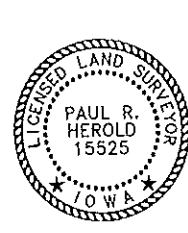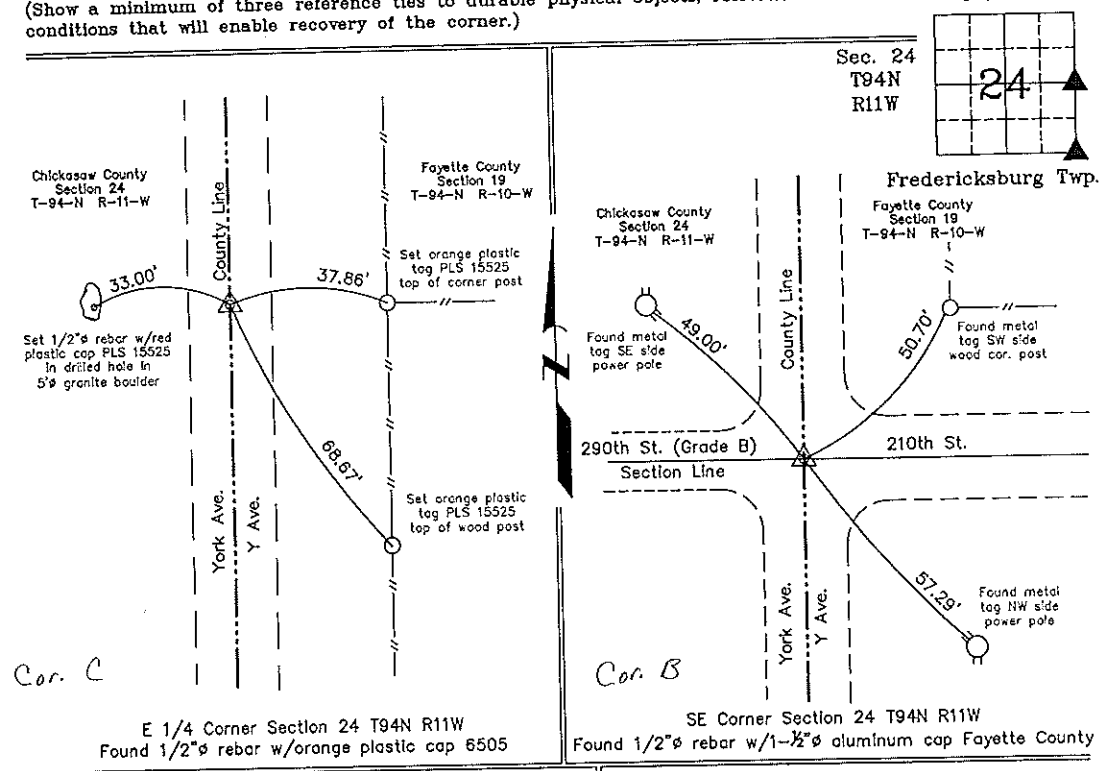

I hereby certify that this land surveying document was prepared and the related survey work was performed by me or under my direct personal supervision and that I am a duly licensed Land Surveyor under the laws of the State of Iowa.

Paul R. Herold 8-21-03
 Paul R. Herold Date
 License number 15525
 My license renewal date is December 31, 2004.
 Sheets covered by this seal: Individual

List Corners to be Indexed			
Corners	Section	Twp.	Range
E 1/4	24	94N	11W
SE	24	94N	11W

Filed 9-18-03
 X:\Section Corners\Sec. 24\24-94-110y.dwg

County Engineer
 Copy