

Chickasaw Co. Recorder
 Cindy Messersmith
 Fee Book 2011-0642
 04/20/2011 @0858AM
 SCC SEC COR CERT
 Book: Page: # Pages: 1
 Total Fees: \$9.00

TeKIPPE ENGINEERING, P.C., 128 South Vine Street, West Union, Iowa 52175 Phone (563) 422-5131

UNITED STATES PUBLIC LAND SURVEY CORNER CERTIFICATE
 OF

Land Survey Monuments situated in Section 22, Township 94 North, Range 11 West of the Fifth Principal Meridian, Chickasaw County, Iowa.
 Previously recorded in none in County Recorder's Office.
 (book, page, document number, etc.)

(Show reason for preparing this certificate, the evidence and detailed procedures used in establishing the corner positions and monumentation found or placed.)


Monument Description and Remarks: SE Corner of Section 22-T94N-R11W.

Found 3/4"Ø iron pin per Chickasaw County Engineer's ties.


PLAN VIEW

Project Number 111049.LS
 Field Book: 46M, Page 73

Show a minimum of three reference ties to durable physical objects, relevant monuments and physical conditions that will enable recovery of the corner.

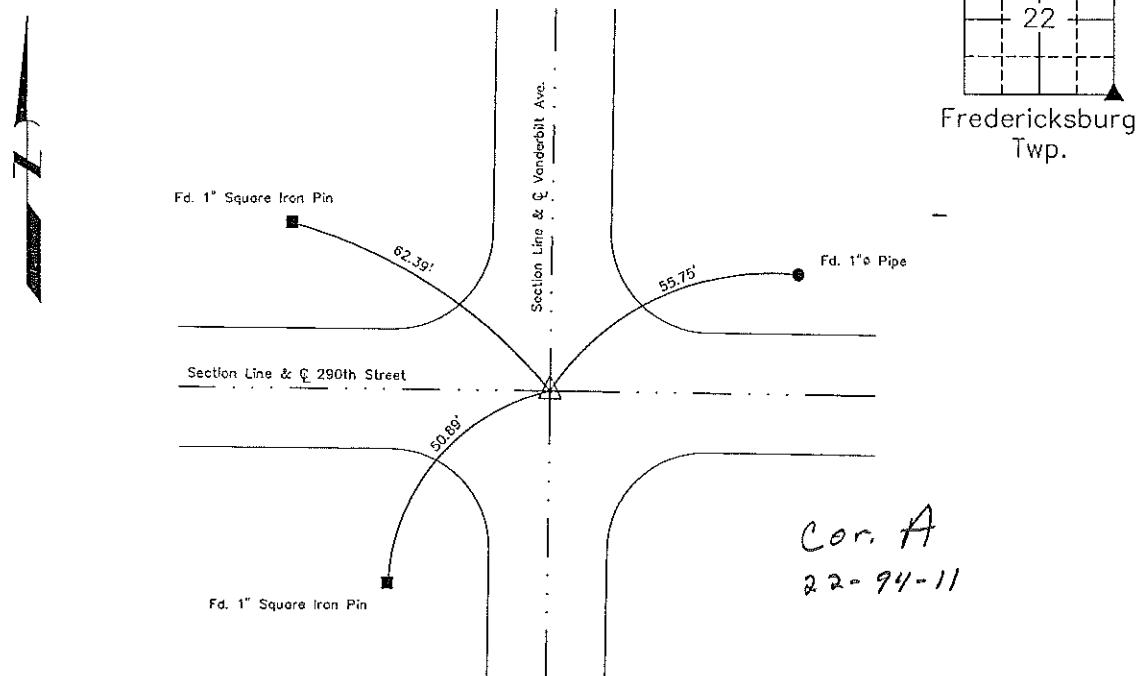

SE Corner of Sec. 22-T94N-R11W
 Found 3/4"Ø Iron Pin

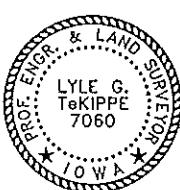I hereby certify that this land surveying document was prepared and the related survey work was performed by me or under my direct personal supervision and that I am a duly licensed Land Surveyor under the laws of the State of Iowa.											
  Lyle G. TeKippe Date License Number 7060 My license renewal date is December 31, 2012. Sheets covered by this seal: Individual											
List Corners to be Indexed <table border="1"> <thead> <tr> <th>Corners</th> <th>Section</th> <th>Twp.</th> <th>Range</th> </tr> </thead> <tbody> <tr> <td>SE</td> <td>22</td> <td>94N</td> <td>11W</td> </tr> </tbody> </table>				Corners	Section	Twp.	Range	SE	22	94N	11W
Corners	Section	Twp.	Range								
SE	22	94N	11W								
X:\Section Corners\Sec. 22\22-94-11Y.dwg											

Instrument #: 2018-0952
 05/31/2018 01:06:39 PM Total Pages: 1
 SCC SECTION CORNER CERTIFICATES
 Recording Fee: \$ 7.00
 Cindy Messersmith, Recorder, Chickasaw County, Iowa

SHIMAK SURVEYING, P.LLC., 3212 335th Street, Cresco, Iowa 52136 Phone (663) 379-3699

UNITED STATES PUBLIC LAND SURVEY CORNER CERTIFICATE

OF 27

Land Survey Monuments situated in Section 26, Township 94 North, Range 11 West of the Fifth Principal Meridian, Chickasaw County, Iowa. Previously recorded in 1.) Fee Bk. 2011-0642 2.) None in County Recorder's Office. (book page, document number, etc.)

(Show reason for preparing this certificate, the evidence and detailed procedures used in establishing the corner positions and monumentation found or placed.)

Monument Description and Remarks: 1.) NW Corner of Section 26-T94N-R11W:

Fd. 3/4"ø Iron Pin. 1.5' Deep from Previous Section Corner Certificate.


One Tie is missing. Ties were Placed as Shown Below.

2.) NW Corner of the SW 1/4 - NW 1/4 of Section 26-T94N-R11W:


Set 1/2"ø Rebar w/Yellow Plastic Cap PLS 16961 at the intersection of the West Section Line and an existing East-West Fence after comparing to Warranty Deed and occupation lines.

One Tie is missing. Ties were Placed as Shown Below.

PLAN - VIEW

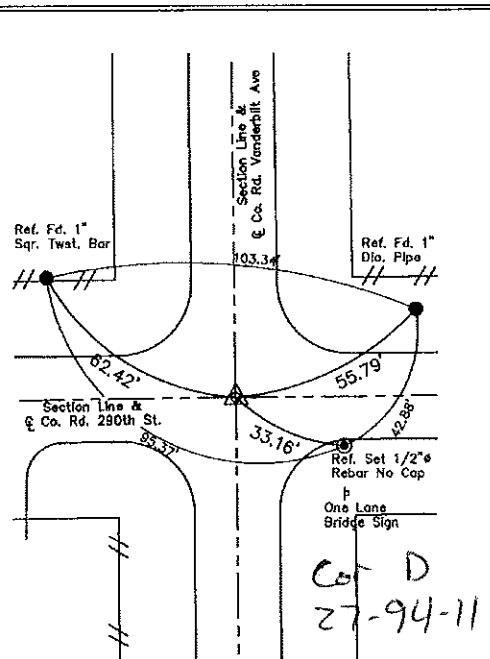

NW Corner of Section 26-T94N-R11W
 Fd. 3/4"ø Iron Pin (1.5' Deep)

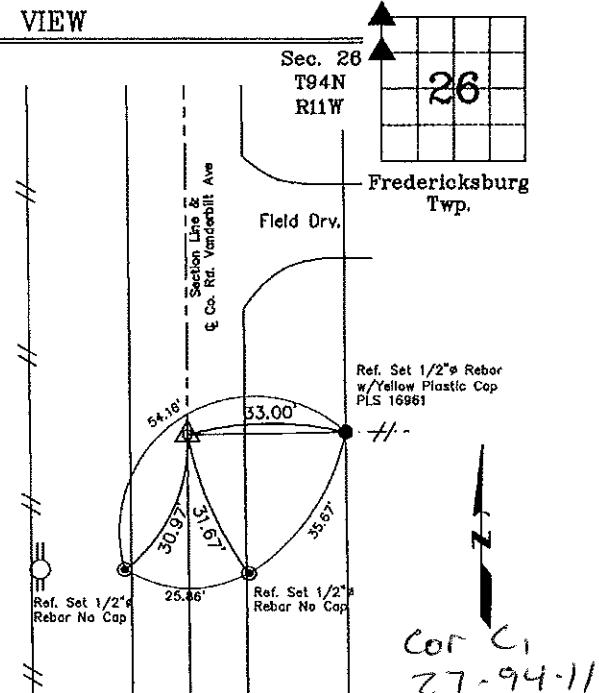

NW Corner of the SW 1/4 - NW 1/4
 of Section 26-T94N-R11W
 Set 1/2"ø Rebar w/Yellow Plastic Cap PLS 16961



I hereby certify that this land surveying document was prepared and the related survey work was performed by me or under my direct personal supervision and that I am a duly licensed Land Surveyor under the laws of the State of Iowa.

Michael J. Shimak 5-31-2019
 Michael J. Shimak Date:

License number 16961
 My license renewal date is December 31, 2019.
 Sheets covered by this seal: Sheet P1

List Corners to be Indexed

Corners	Section	Twp.	Range
NW Corner	26	94N	11W
NW-SW-NW Cor.	26	94N	11W

Project Number: 19-07-16.II
 FB. Howard/Chickasaw No. 1, Pgs. 6-10