

Section 33-95-11  
As referred to in  
Engr. Tee Book

UNITED STATES PUBLIC LAND SURVEY CORNER CERTIFICATE

OF 33


Land Survey Monuments situated in Section 4, Township 94 North, Range 11 West, of the Fifth Principal Meridian, CHICKASAW County, Iowa.  
Previously recorded in NONE in County Recorder's Office.  
(book page, document number, etc.)

(Show reason for preparing this certificate, the evidence and detailed procedures used in establishing the corner positions and monumentation found or placed.)

Monument Description and Remarks: N 1/4 CORNER SECTION 4 T94N R11W: FOUND 1 1/2" Ø GAS PIPE @ Q. OF 250TH ST IN LINE WITH N&S FENCES, PREVIOUSLY UNRECORDED, PIPE WAS FOUND 0.2 DEEP.  
E 1/4 CORNER SECTION 4 T94N R11W: FOUND PK NAIL @ Q. OF COUNTY ROAD V-56 MATCHING COUNTY ENGINEER TIES.


PLAN - VIEW

(Show a minimum of three reference ties to durable physical objects, relevant monuments and physical conditions that will enable recovery of the corner.)

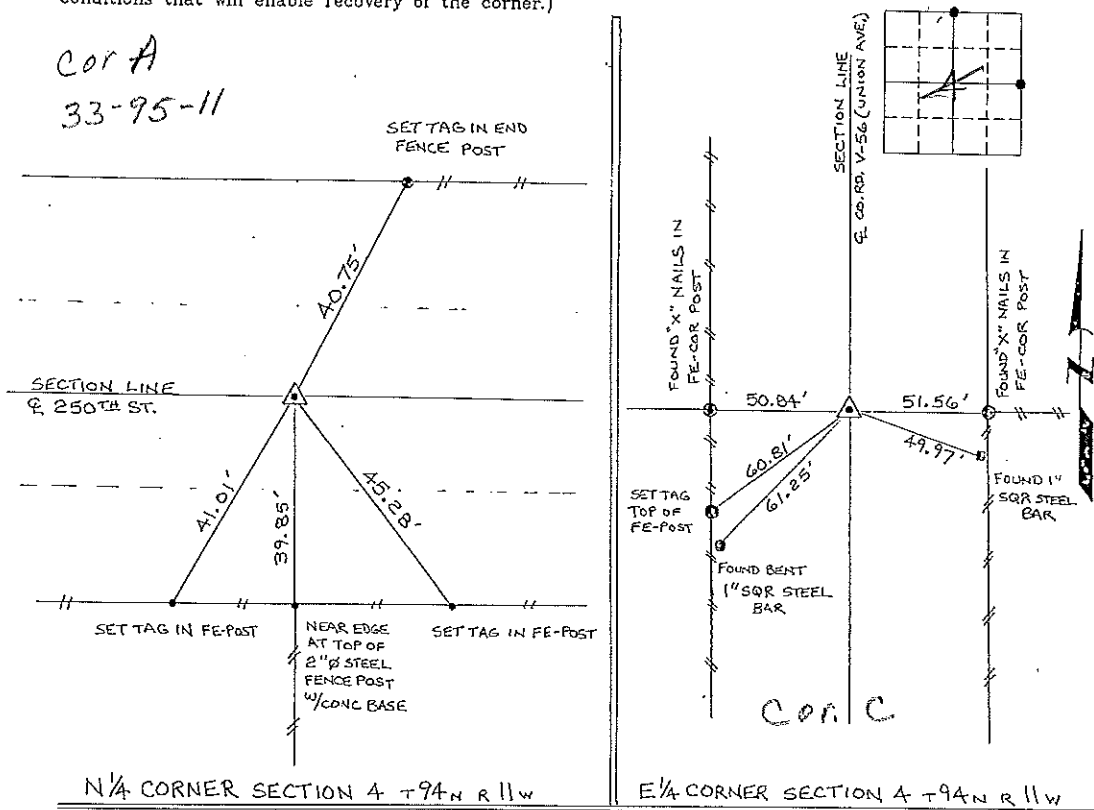

I hereby certify that the survey work was completed and this certificate was prepared by me or under my direct personal supervision and that I am a duly registered land surveyor under the laws of the state of Iowa.

Signature: Lyle G. TeKippe  
Lyle G. TeKippe  
Date: 8-22-95 Reg. No. 7060  
My Registration Renewal Date is December 31, 1996

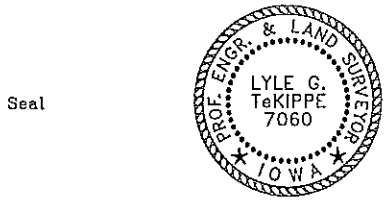

List Corners to be Indexed			
Corners	Section	Twp.	Range
N 1/4	A	94N	11W
Cor A 33-95-11			
E 1/4	A	94N	11W
Cor C-4-94-11			

Placed in  
tee Book  
9/1/95

"County Engineer's Copy"