

Sec. 28-94-11
 AS referred to
 IN Engr. Tie Book

Chickasaw Co. Recorder
 Cindy Messersmith
Fee Book 2009-1773
 09/09/2009 @1040AM
 SCC SEC COR CERT
 Book: Page: # Pages: 1
 Total Fees: \$9.00

Herold - Reicks Surveying, 25 1/2 East Main Street, Suite 204, New Hampton, IA 50658, Ph. 641-394-2725

UNITED STATES PUBLIC LAND SURVEY CORNER CERTIFICATE

Land Survey Monuments situated in Section ²⁸ 33, Township 94 North, Range 11 West of the Fifth Principal Meridian, Chickasaw County, Iowa. Previously not recorded in the County Recorder's office.

This certificate is being prepared in compliance with Iowa Code Chapter 355.11 because:


- 1., 2. There is no certificate on file for this corner.
 There are no longer three valid ties of record.
 There are changes to reference ties of record.
 There is change of monumentation of record.
 To clarify description of record monument (ties).

Monument Description and Remarks:

- 1.) **North 1/4 Corner:** Found 1/2" square twisted bar from information obtained from the County Engineer's office in book "Section Ties", Fredericksburg Township, Section 28, Corner "A".
 2.) **Northeast Corner:** Set cut "X" in PCC roadway from information obtained from the County Engineer's office in book "Section Ties", Fredericksburg Township, Section 28, Corner "B".

PLAN - VIEW

(Show a minimum of three reference ties to durable physical objects, relevant monuments and physical conditions that will enable recovery of the corner.)

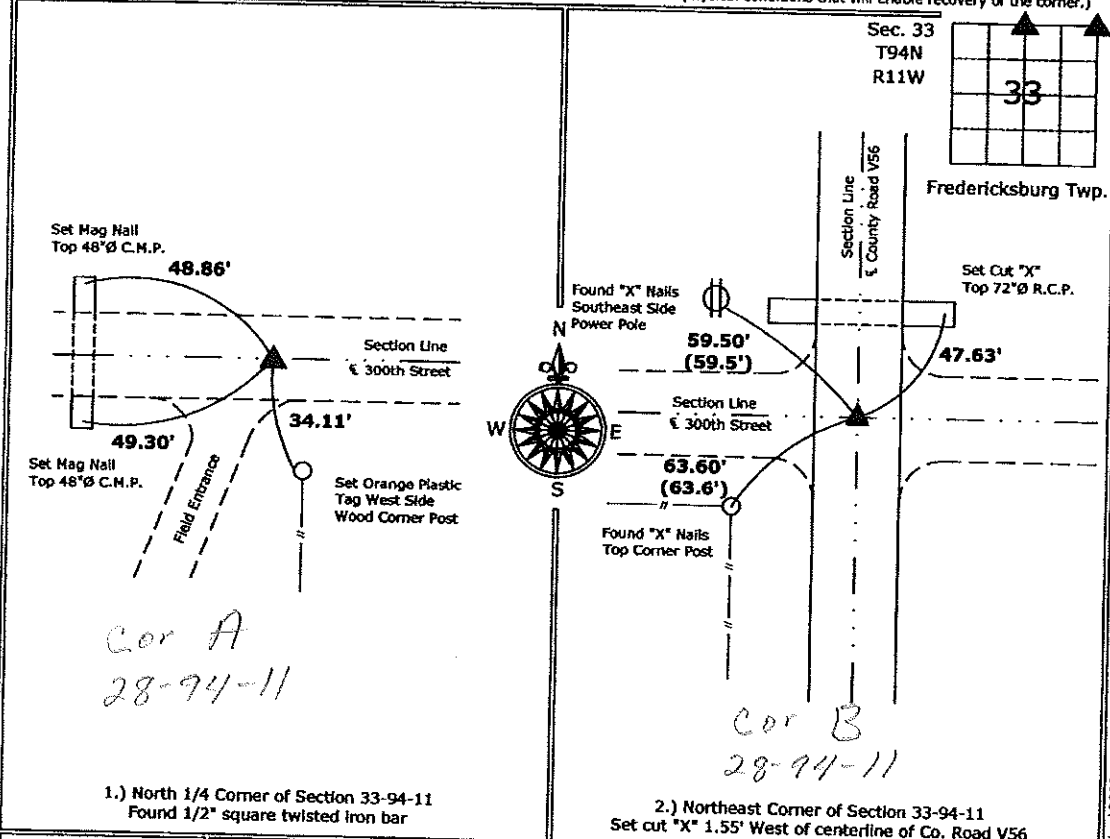

File: S:\Projects\2009-104\wing\2009-104.dwg, 9/9/2009 5:20:55 AM



I hereby certify that this land surveying document was prepared and the related survey work was performed by me or under my direct personal supervision and that I am a duly licensed Land Surveyor under the laws of the State of Iowa.

Kirk D. Reicks 9-9-09
 Kirk D. Reicks Date:

License number 19211
 My license renewal date is December 31, 2010.
 Sheets covered by this seal: Individual sheet only

List Corners to be Indexed			
Corners	Section	Twp.	Range
N 1/4	33	94	11
NE	33	94	11

Project Number: 2009-104
 FB: Chickasaw County 1, Pgs. 17-18